
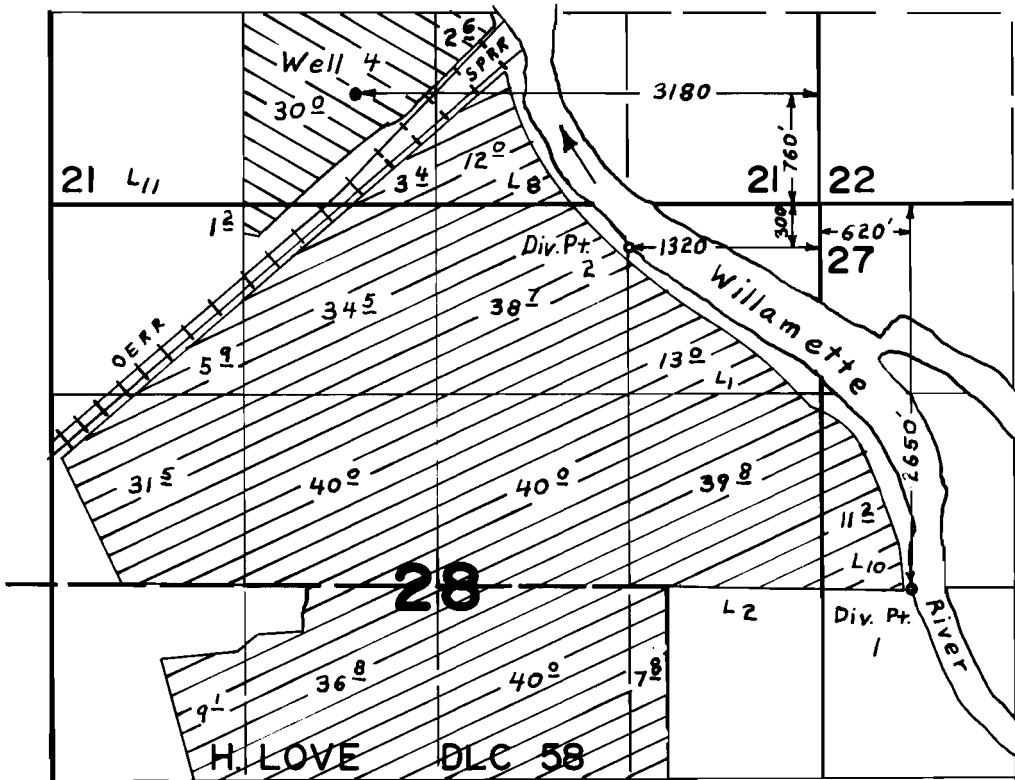



T.15S. R.4W., W.M.

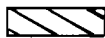

-  App'l. G-5751
-  App'l. 44044

FINAL PROOF SURVEY UNDER

49049 36701
 Application No. G-5751 Permit No. G-5537.
 IN NAME OF

ROONEY B and AILEEN R KRAGNESS

Surveyed APR. 25, 1978, by J.S. DONALDSON