


# T. 15S. R. 4W. W. M.

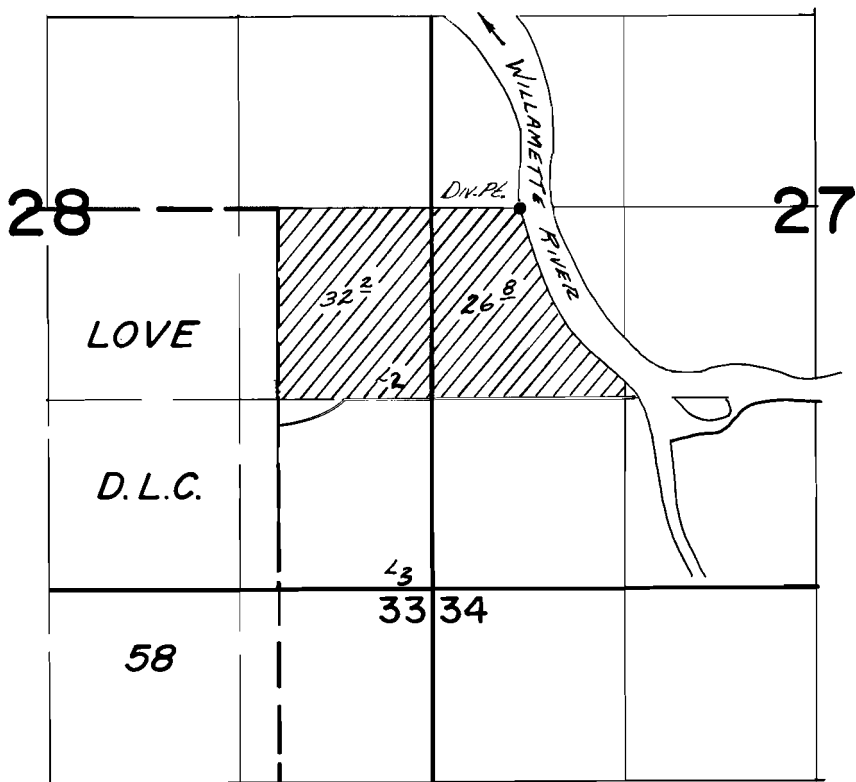

*Dk. Pt. Loc. - 1660' Due East of N.E. Cor.  
of H. LOVE D.L.C. 58*

## FINAL PROOF SURVEY UNDER

Application No. 5.5.197... Permit No. 4.1.7.9.0.....  
IN NAME OF

.....**BOWERS DISTILLERY INC.**.....

Surveyed .Oct..10.. 1979., by C.R.RODRIGUEZ.