


T.16S. R.4W., W.M.

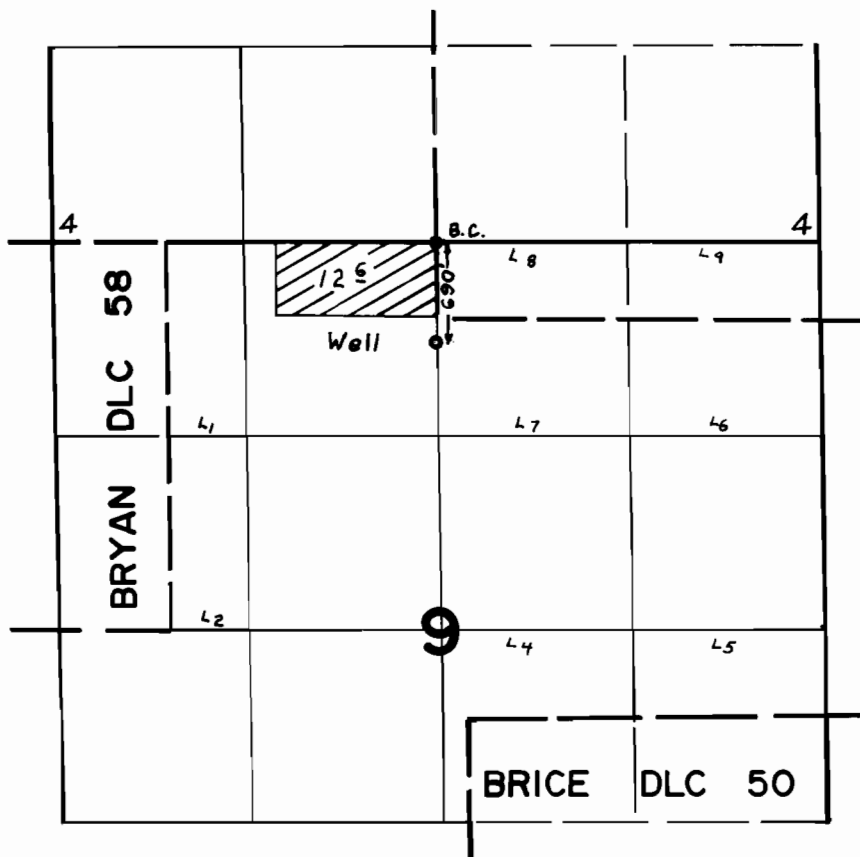

FINAL PROOF SURVEY UNDER

Application No. G-7828 Permit No. G-7220
IN NAME OF

GERALD J. & LORENCE R. EDWARDS

Surveyed SEP. 13. 1978. by J.S. DONALDSON