


# T.16S. R.4W., W.M.

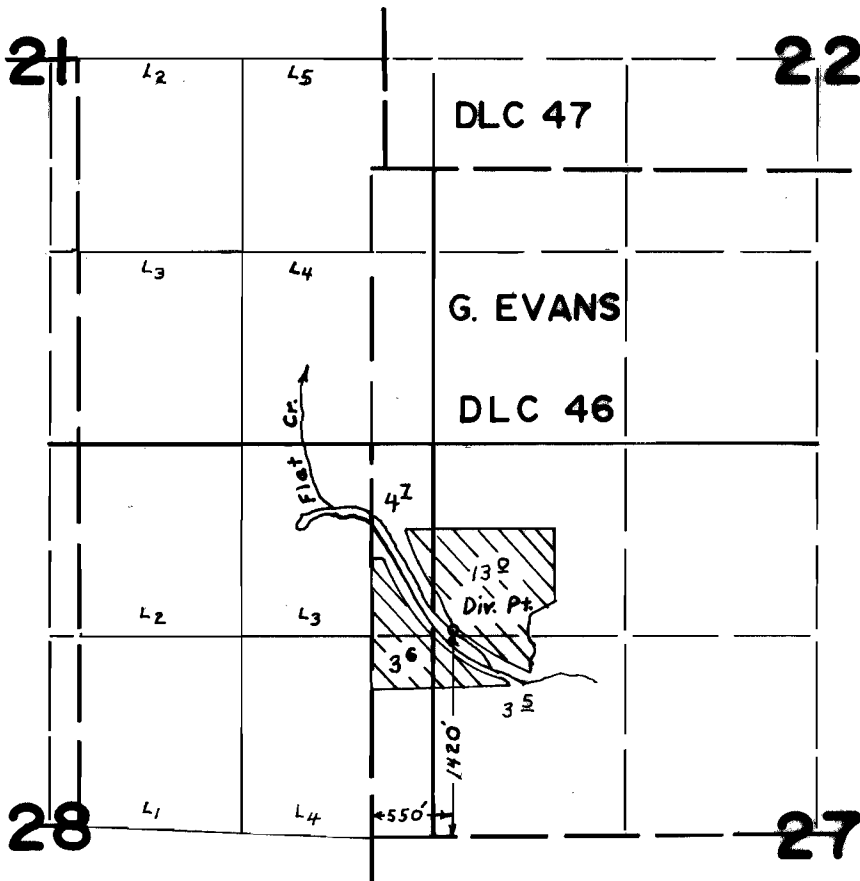

## FINAL PROOF SURVEY UNDER

Application No. 53710..... Permit No. 40151.....  
IN NAME OF

HARRISON I. & MARIE C. SCOTT

Surveyed APR. 27. 1978., by J.S. DONALDSON