


T.16S. R.7W., W.M.

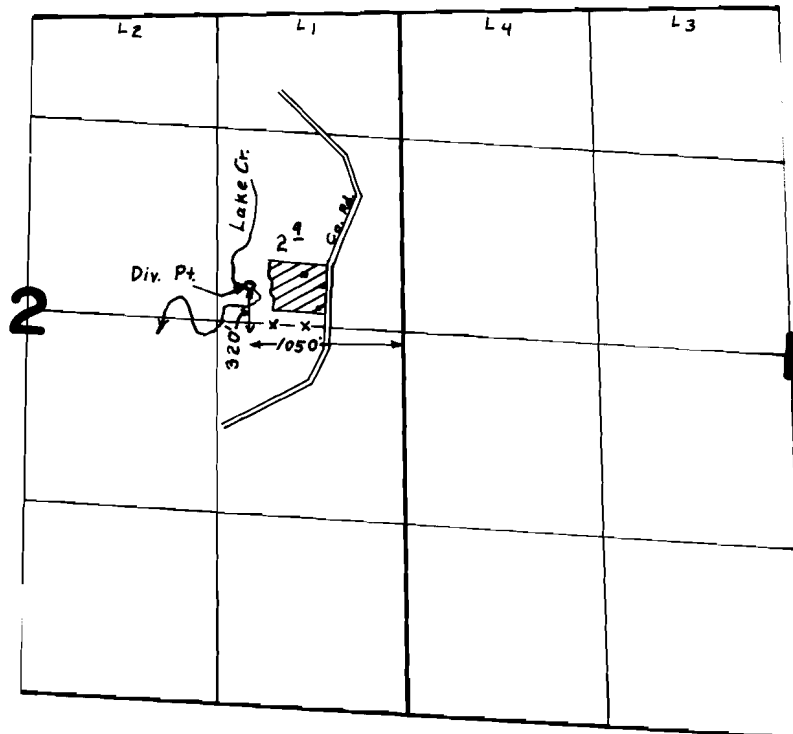

FINAL PROOF SURVEY
UNDER

Application No. 5412.6... Permit No. 40518...
IN NAME OF

..... JOSEPH DRAGO

Surveyed SEP. 13... 1978., by J.S. DONALDSON