


# T18S. R2W. WM.

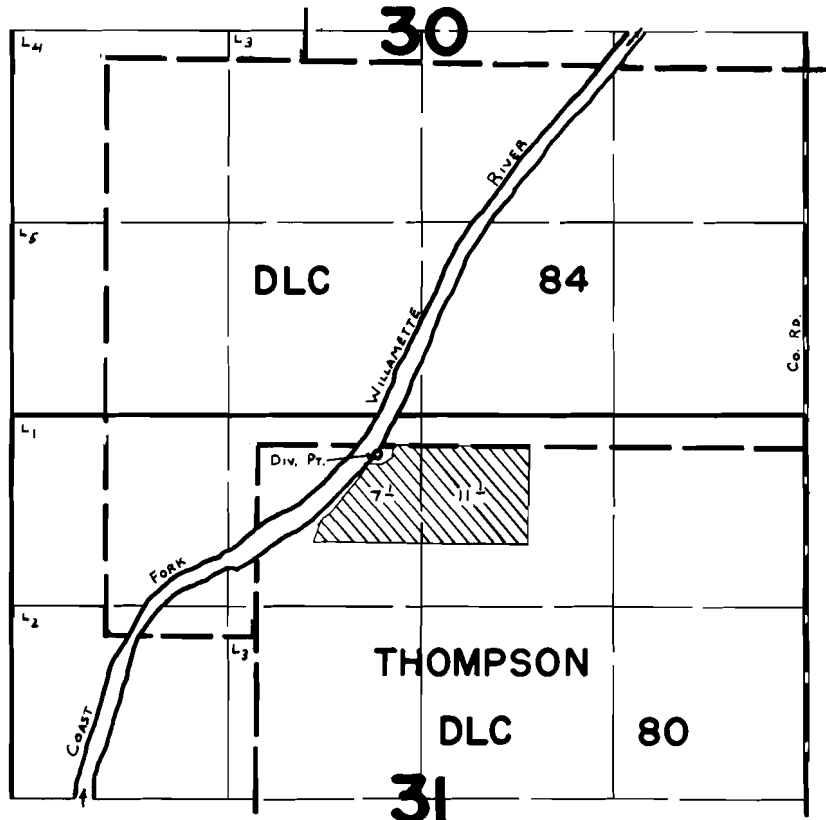

Div. Pt. Loc: 60'S. & 2930' W. fr. N.E. Cor. THOMPSON DLC. 80.

## FINAL PROOF SURVEY UNDER

Application No. 54174 Permit No. 40921  
IN NAME OF

MARCUS H. BRINK

Surveyed MAY 23, 1978, by C. L. HUGHES