


T.I.I.S.R.I.I.W.W.M.

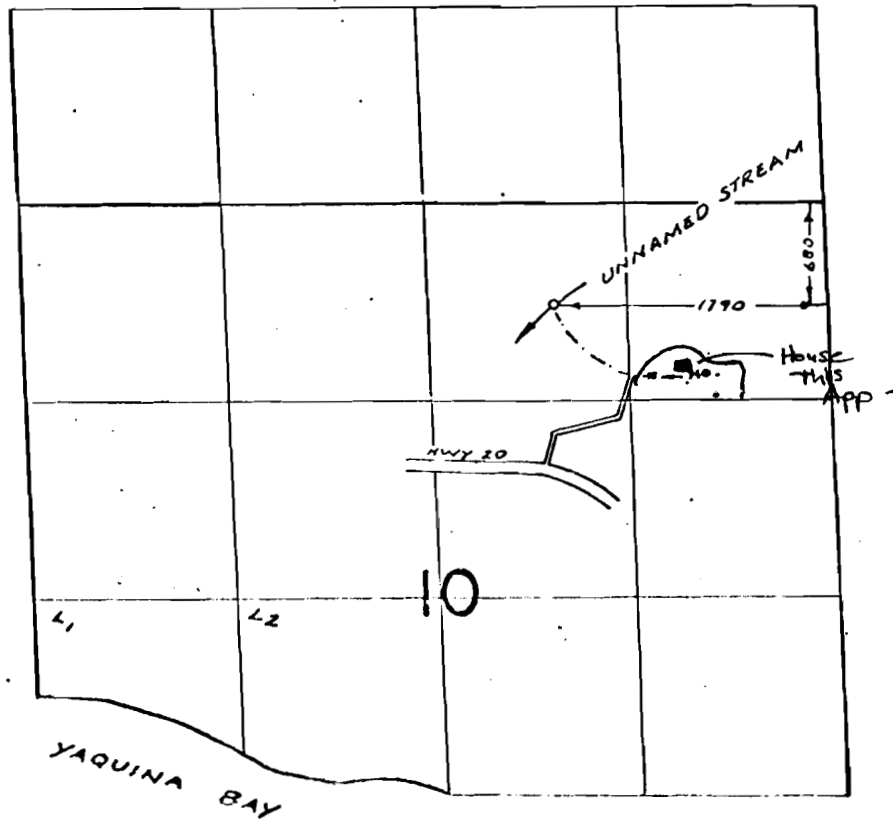

FINAL PROOF SURVEY
UNDER

Application No. 11114... Permit No. 32229...
IN NAME OF

WILLIAM A. F. MARRIOTT E. WILLIAMSON

Surveyed 1922, 1923, by R. MACKEN...

RECEIVED

APR 2 1976

WATER RESOURCES DEPT.
SALEM, OREGON

Application No. 54079
Permit No. 40491