

Application No. 56967


Permit No. 42910 T.I.S., R.I.O.W., W.M.

New

RECEIVED

MAR 7 1978

WATER RESOURCES DEPT.
SALEM, OREGON

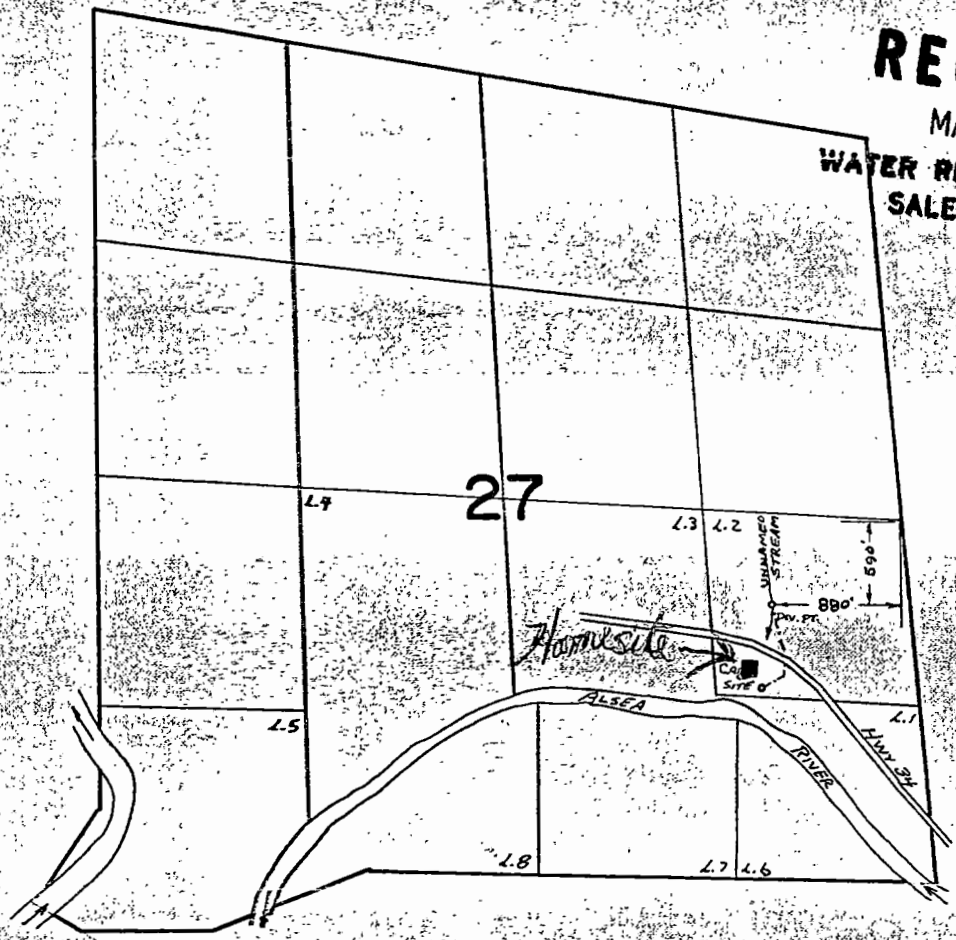

FINAL PROOF SURVEY
UNDER

Application No. 49372 Permit No. 37010
IN NAME OF

CHARLES R. COX

Surveyed SEPT. 10, 1975, by L. T. H.