


T.14S.,R.12W.,W.M.

Application No. 56991

Permit No. 42911

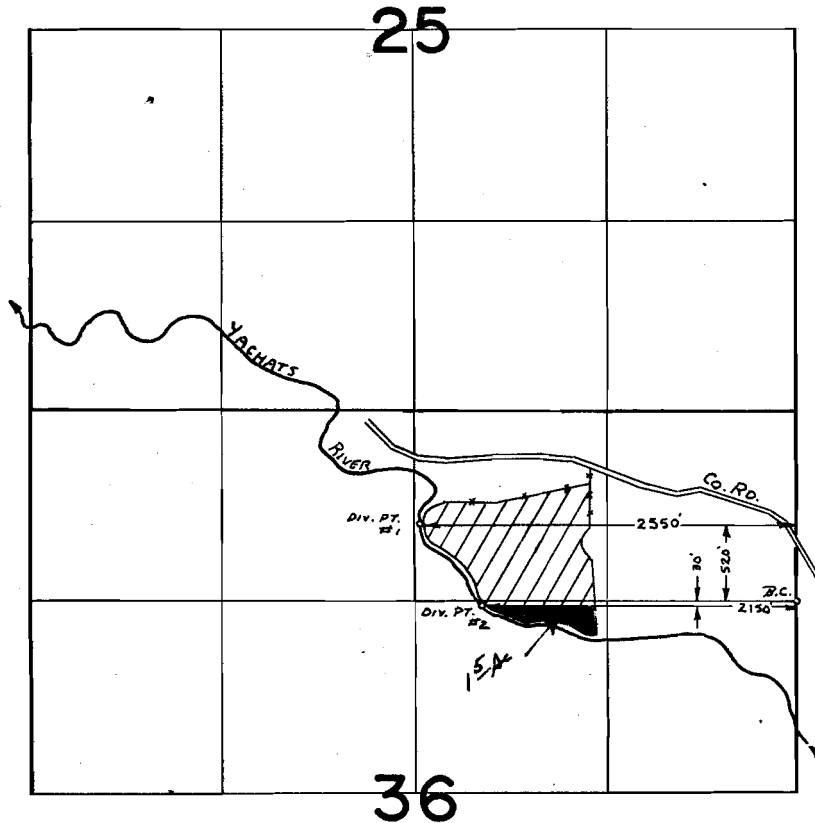

~~FINAL PROOF SURVEY~~

UNDER

~~Application No. 45860 Permit No. 34240~~

IN NAME OF

LEONARD CARSON

Surveyed Aug. 22, 1974, by D. NORBY  
SEPT. 8, 1975 L. T. 11