


MAP FOR GEORGE VANAGTMAEL
IN SW 1/4, SEC. 23, T.9 S., R.1 E., W.M.
LINN COUNTY, OREGON
SEPTEMBER 23, 1976

Application No. 54876
Permit No. 41161

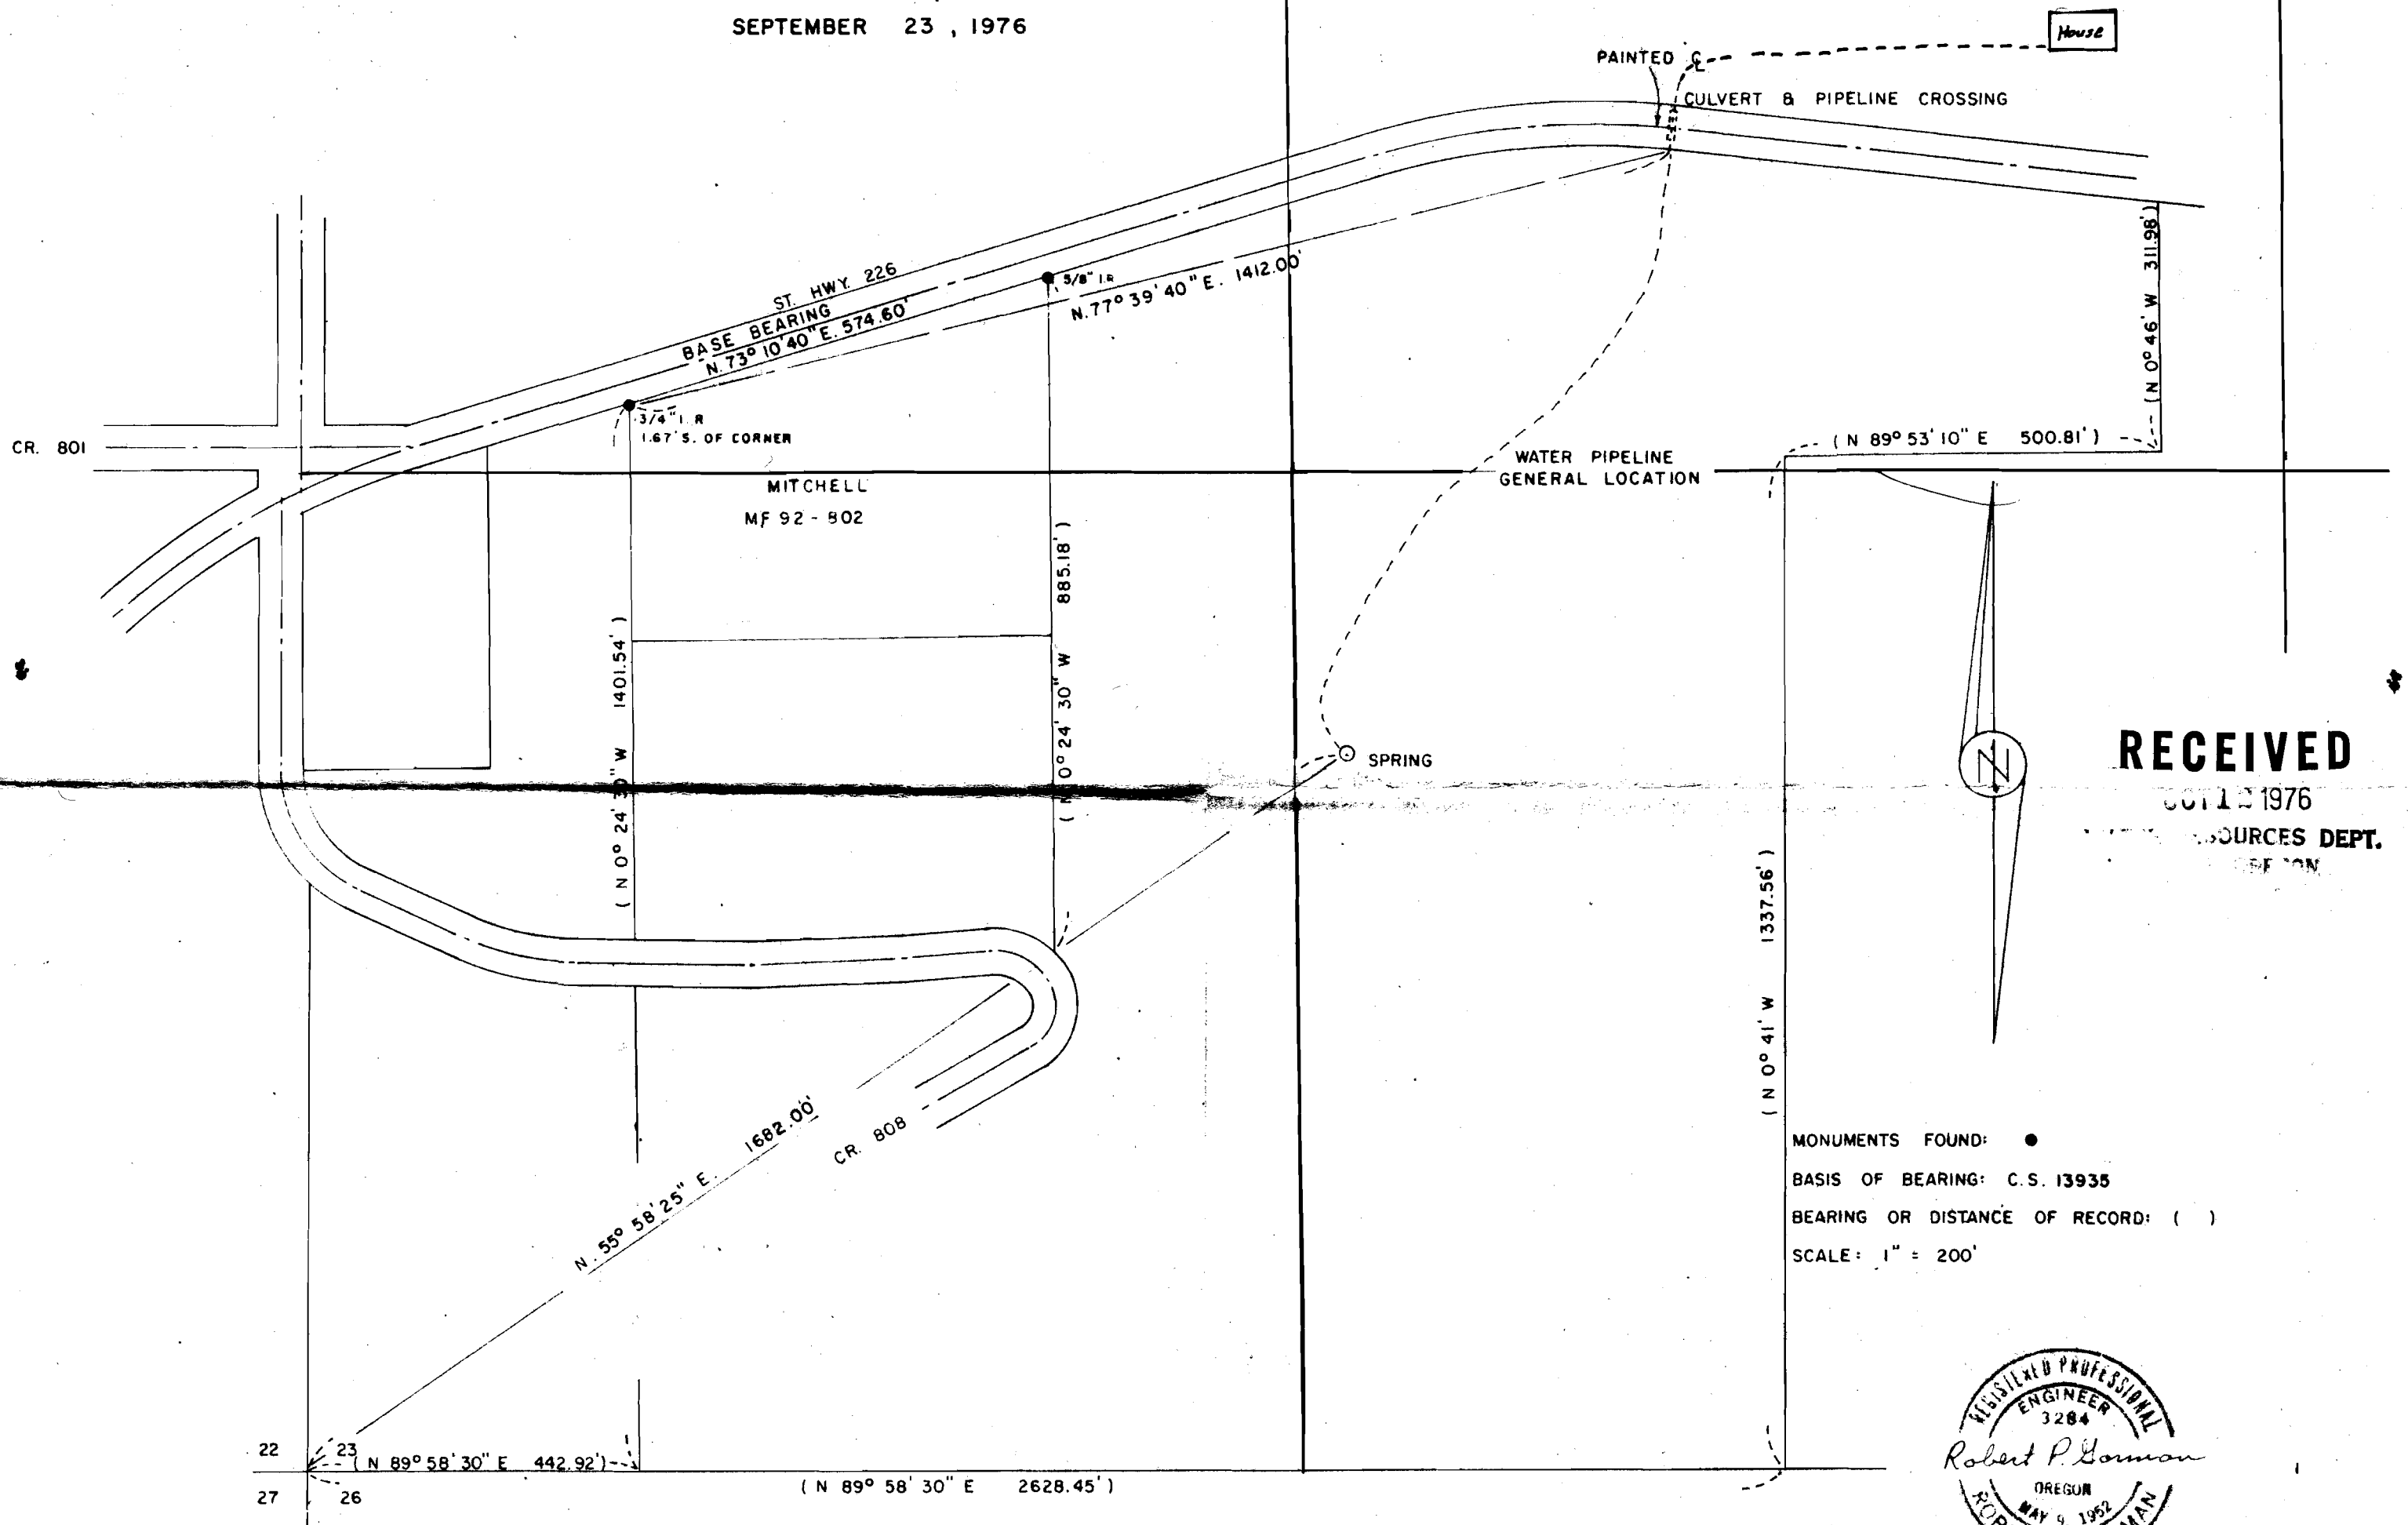

ROBERT P. GORMAN C. E.
PO. BOX 97, STAYTON, ORE.

C.J.J.