


# T.I.S. R.I.W., W.M.

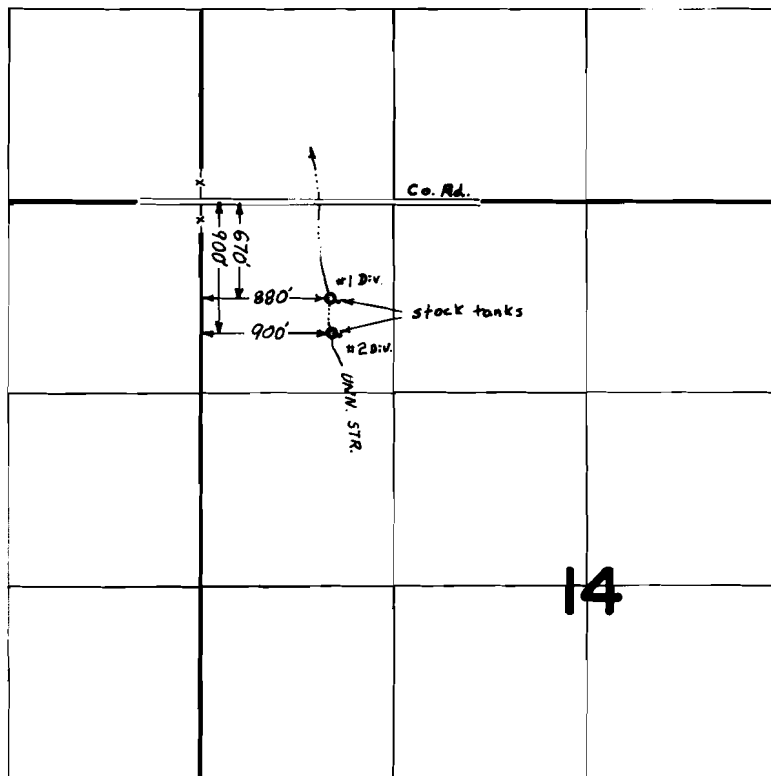

## FINAL PROOF SURVEY UNDER

Application No. 55622..... Permit No. 41673.....  
IN NAME OF

.....GERALD C. MERSEREAU.....

Surveyed APR. 13. 1978., by S. P. APPLGATE