


T. 4 S. R. 3 W. W. M.

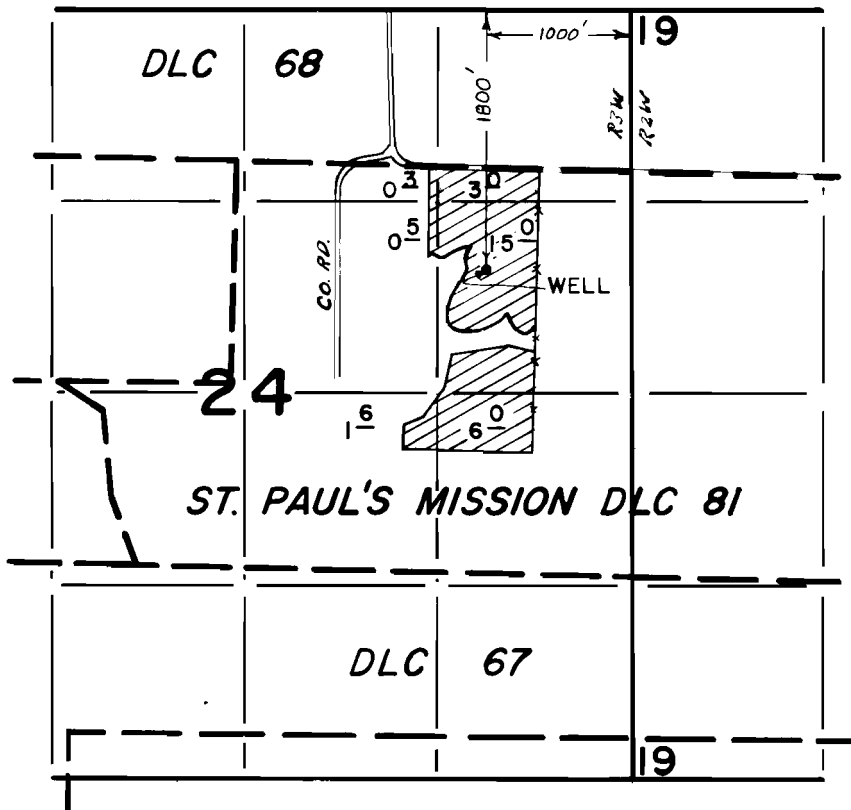

**FINAL PROOF SURVEY**  
UNDER

Application No. G-5641. Permit No. G-5464  
IN NAME OF

**ALFRED E. SMITH**

Surveyed SEPT. 27, 1978, by S.P. APPLGATE