


T. 2N. R. 24E. W.M.

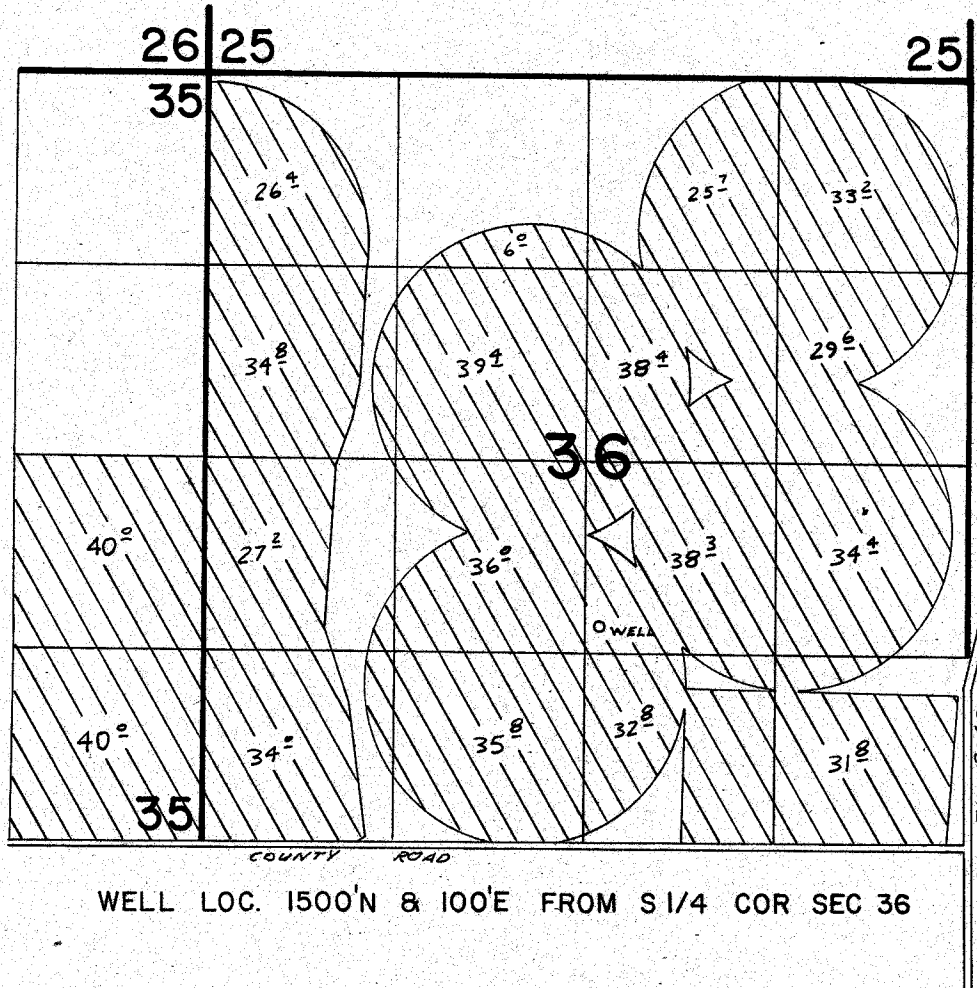

FINAL PROOF SURVEY
UNDER

Application No. G-6342 Permit No. G-5238
IN NAME OF

ERIC ANDERSON

Surveyed 10-25 1978, by R. BARVILY