


G-6661
50854

T. 5N. R. 26 E. W.M.

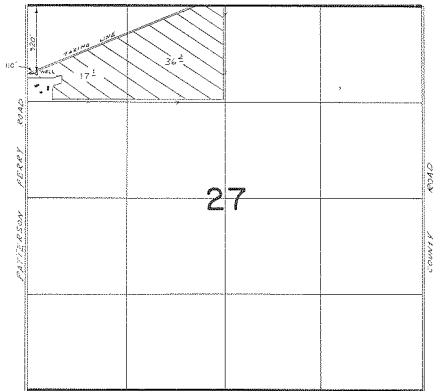

FINAL PROOF SURVEY
UNDER

Application No. G-6017... Permit No. G-6661...
IN NAME OF

...WALLACE A. FREDERICKSON...

Surveyed 10-30... 1978, by R. BARWIK.....