


# T.3N.R.IW.W.M.

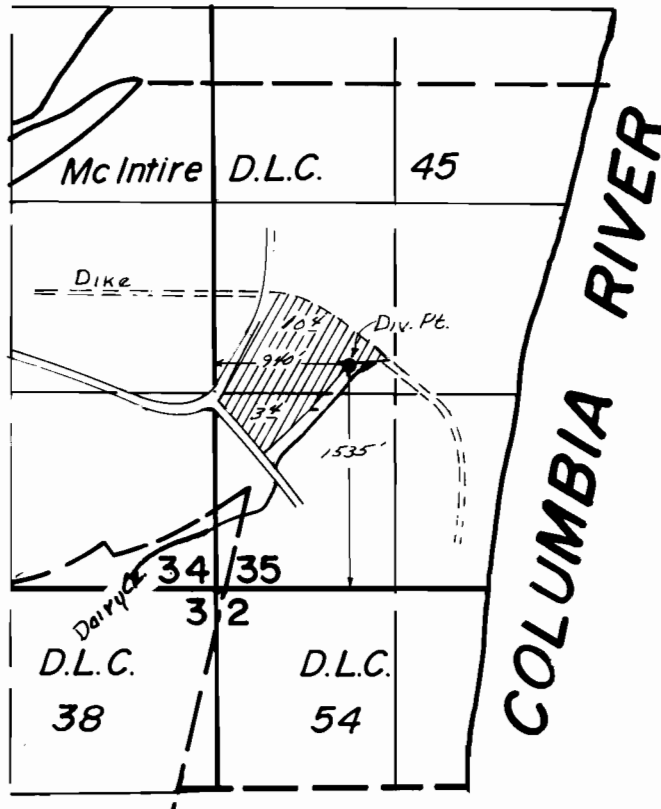

## FINAL PROOF SURVEY UNDER

Application No. 5.5.4.7.2. Permit No. 42195...  
IN NAME OF

.....ROGER L. & NANCY S. TABOR.....

Surveyed Sept. 20 1978. by S.P.Applegate...