


T.7S. R.5&6W., W.M.

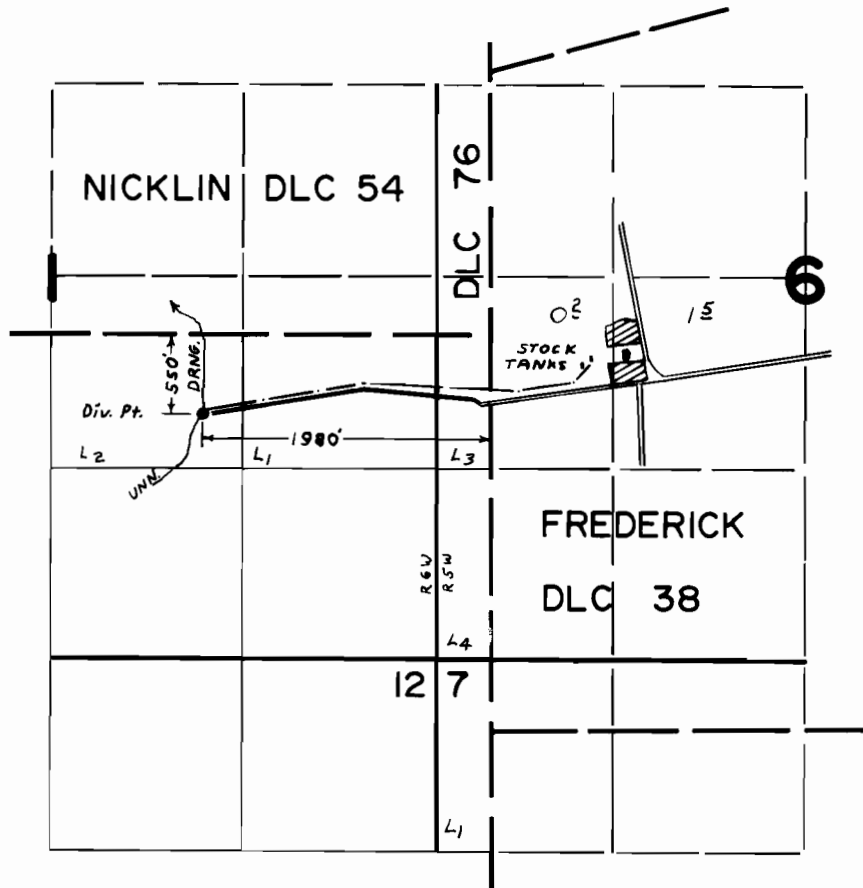

FINAL PROOF SURVEY UNDER

Application No. 52980 Permit No. 40304
IN NAME OF

ALVIN & CARRELL AEBI

Surveyed MAR. 15. 1978. by J. S. DONALDSON