


T.9S.,R.5W.,W.M.

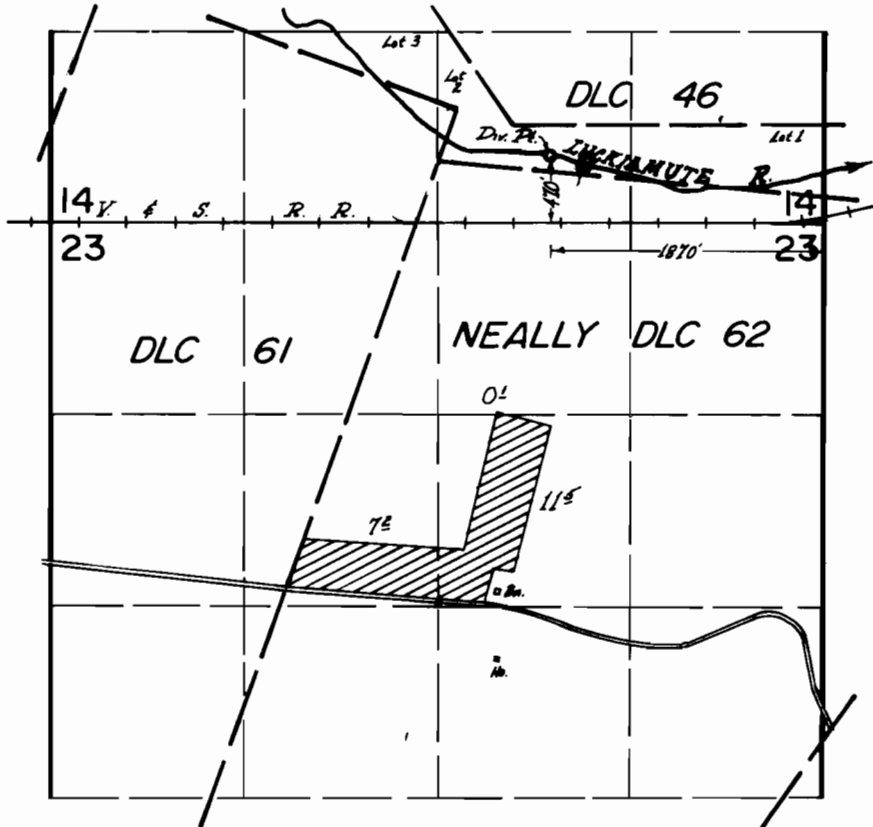

**FINAL PROOF SURVEY**  
UNDER

Application No. 55023 Permit No. 41219  
IN NAME OF

DOROTHY Y. DAVIES

Surveyed Oct. 11, 1978, by *H. Applegate*