


# T. 6S. R. 6W., W.M.

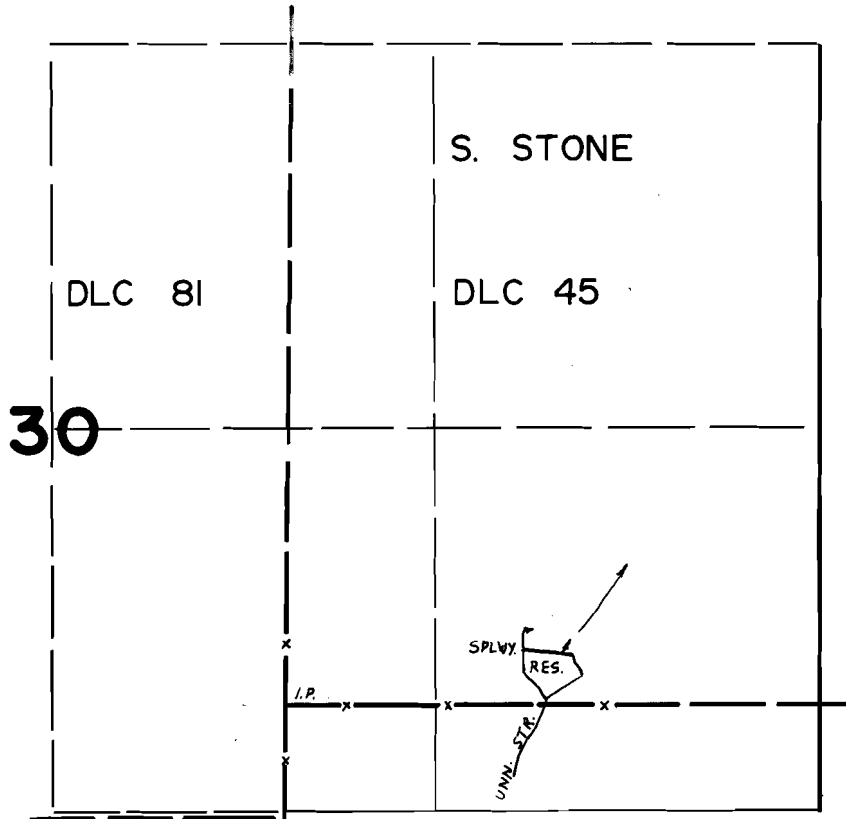

Scale : 1" = 660'

## FINAL PROOF SURVEY UNDER

Application No. R-55851 Permit No. R-6597  
IN NAME OF

T. L. HOGLAN

Surveyed MAR. 6 1978, by J. S. DONALDSON