


T. 3S., R. 10W., W.M.

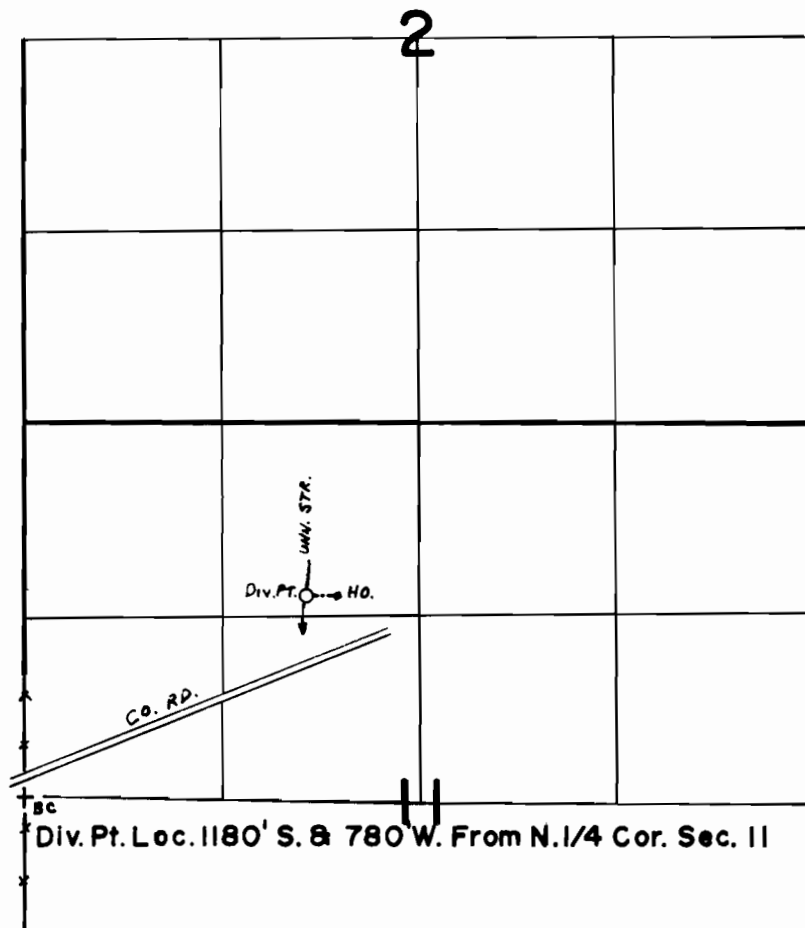

FINAL PROOF SURVEY
UNDER

Application No. 51289..... Permit No. 38731.....
IN NAME OF

PAULINE DAGGETT

Surveyed Apr. 3..... 1978, by J.S. DONALDSON