


T.1&2S.,R.9W.,W.M.

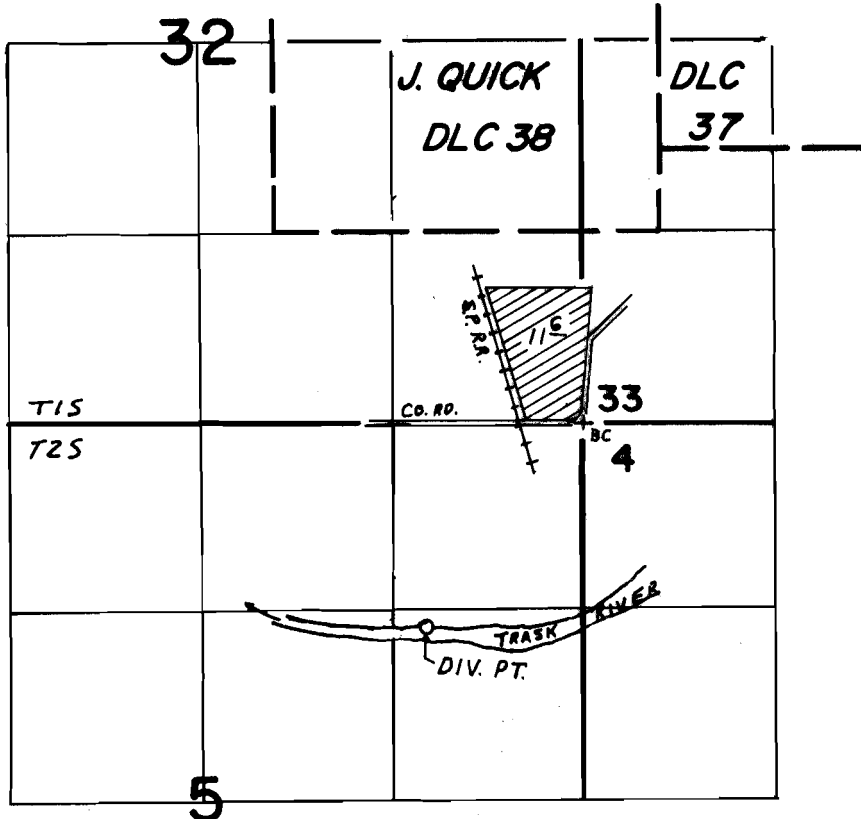

DIV. PT. LOC. 1400'S. & 1100'W. FROM NE COR. SEC. 5

**FINAL PROOF SURVEY**  
UNDER

Application No. 53666... Permit No. 40128...  
IN NAME OF

DANE & CAROL M. LEUTHOLD...

Surveyed Apr. 6... 1978, by J.S. DONALDSON