


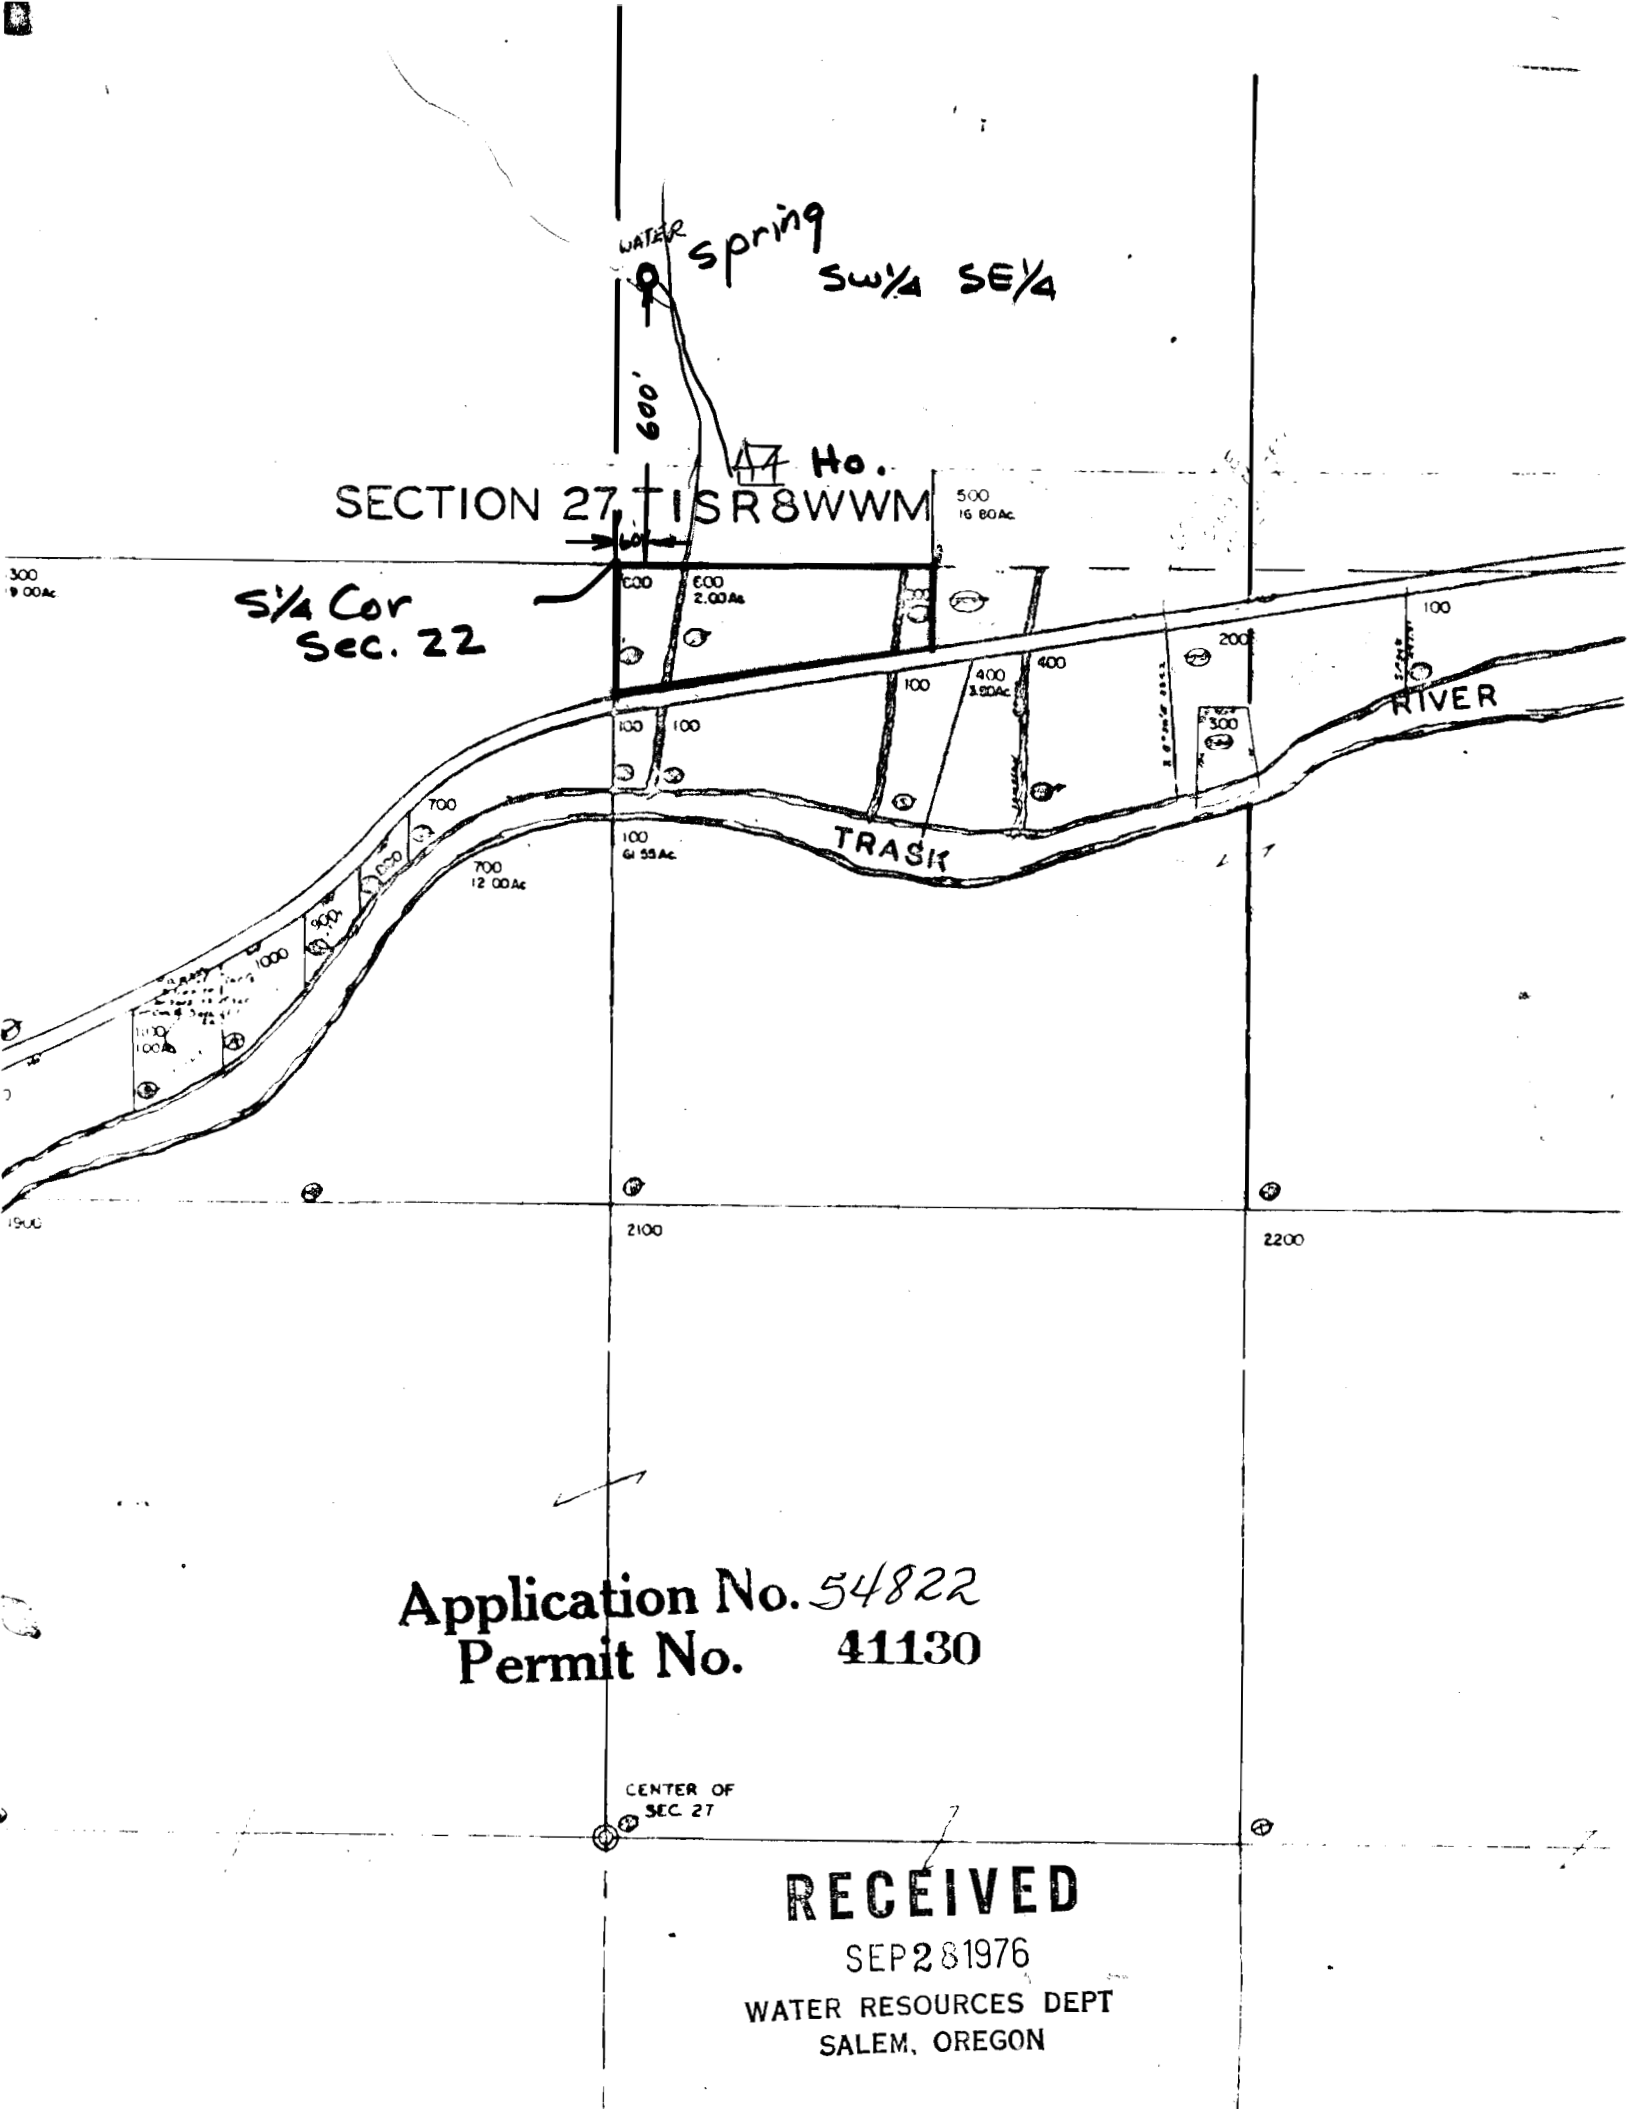

Application No. 54822
Permit No. 41130

RECEIVED

SEP 28 1976

WATER RESOURCES DEPT
SALEM, OREGON

