


T. 2S. R. 44E. W. M

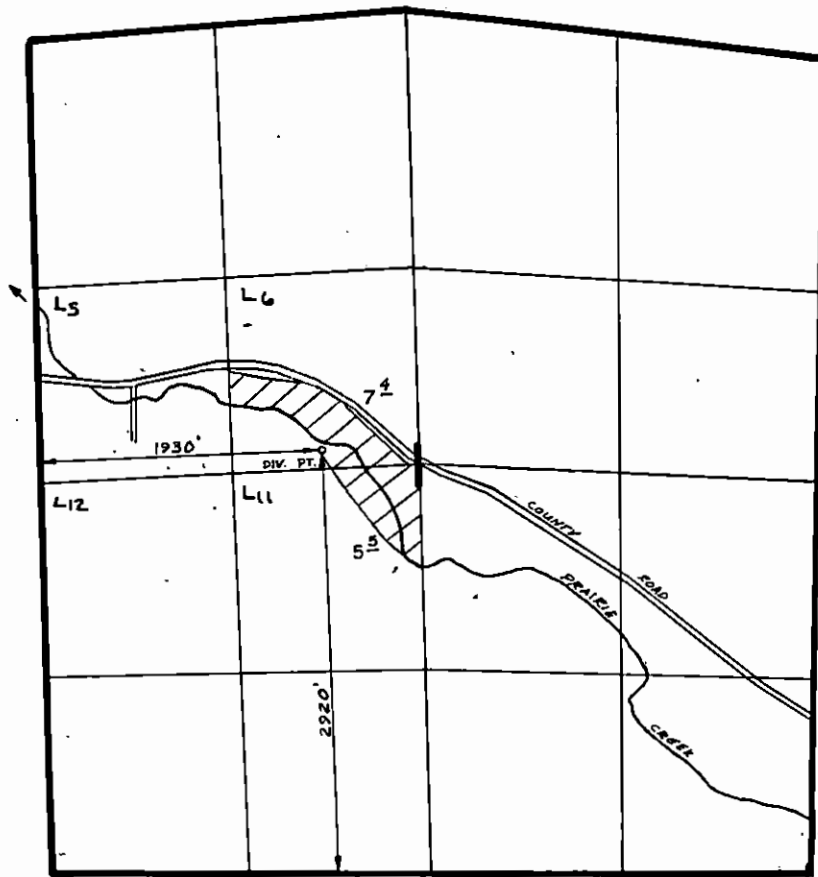

FINAL PROOF SURVEY
UNDER

Application No. 55741 Permit No. 41747
IN NAME OF

WALTER L. ASTWOOD

Surveyed 8-23 1978, by R. BARWIN