


T. 2S. R. 2W. W.M.

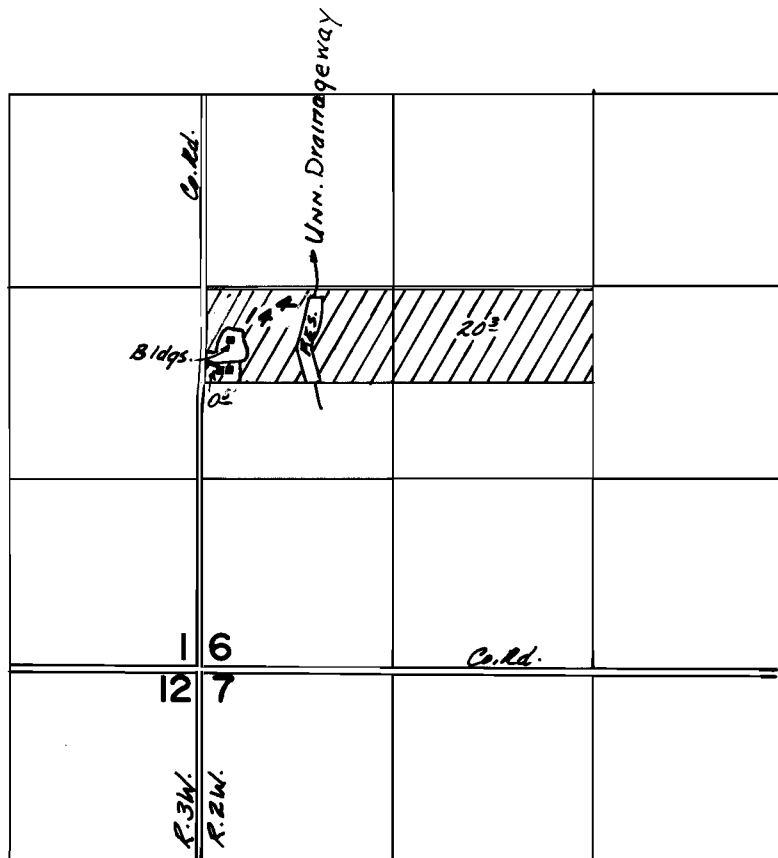

P.O.D. : 50'S and 750'E from W¹/₄ cor Section 6

FINAL PROOF SURVEY
UNDER

R-49586 R-6037
Application No. 49587... Permit No. 37210....
IN NAME OF

.....GLEN & BERNICE KENNEL.....

Surveyed July 26, 1978, by R.G. Mucken....