T1N. R4W. WM.

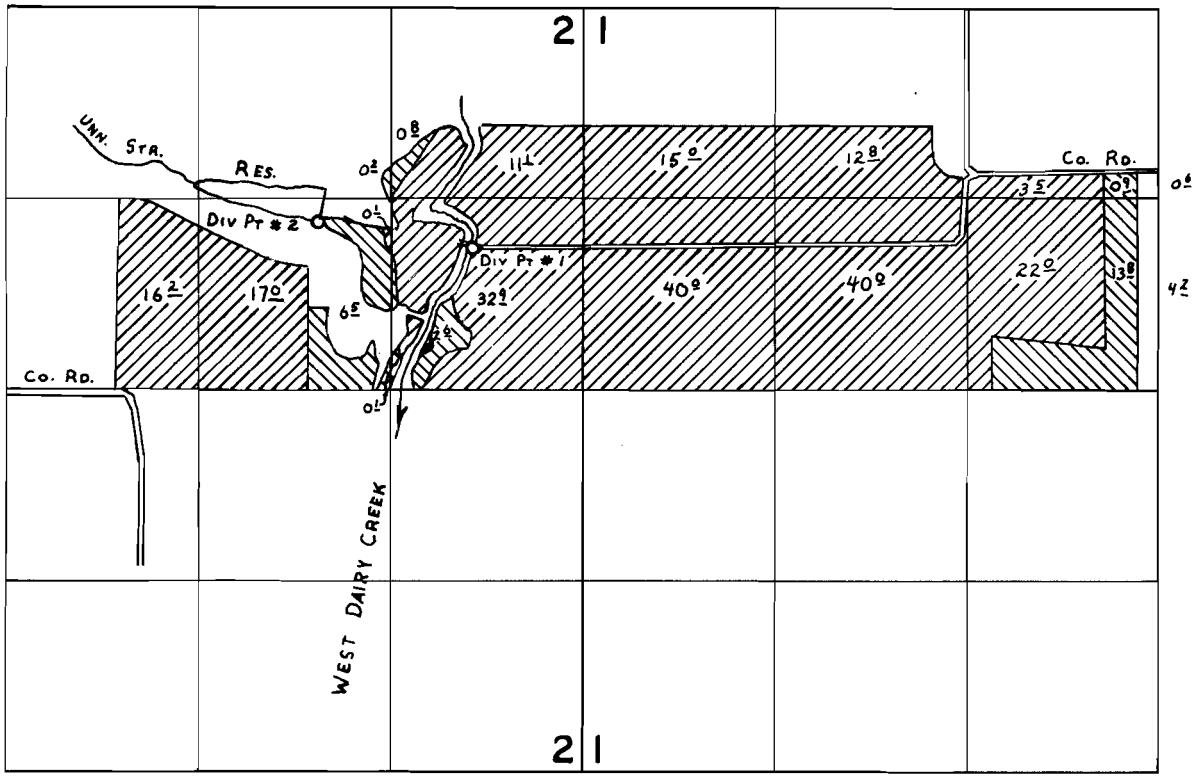

DIV. PTS. LOCATED: #1- 1650'S. & 760'W. } BOTH fr. NE COR SEC 2.
#2- 1480'S. & 1825'W.

PRIMARY IRRIGATION (APP. # 51769) SUPPLEMENTAL IRRIGATION (APP. # 51771)

SUPPLEMENTAL IRRIGATION (APP. # 51769, 51771)

FINAL PROOF SURVEY

UNDER

51769 37338
R-51770 R-6062

Application No. 51771 Permit No. 37339

IN NAME OF

RAYMOND DIERICKX

Surveyed AUG. 9 1978, by C. L. HUGHES

DBS-2LL-72