


T.2S., R.3W., W.M.

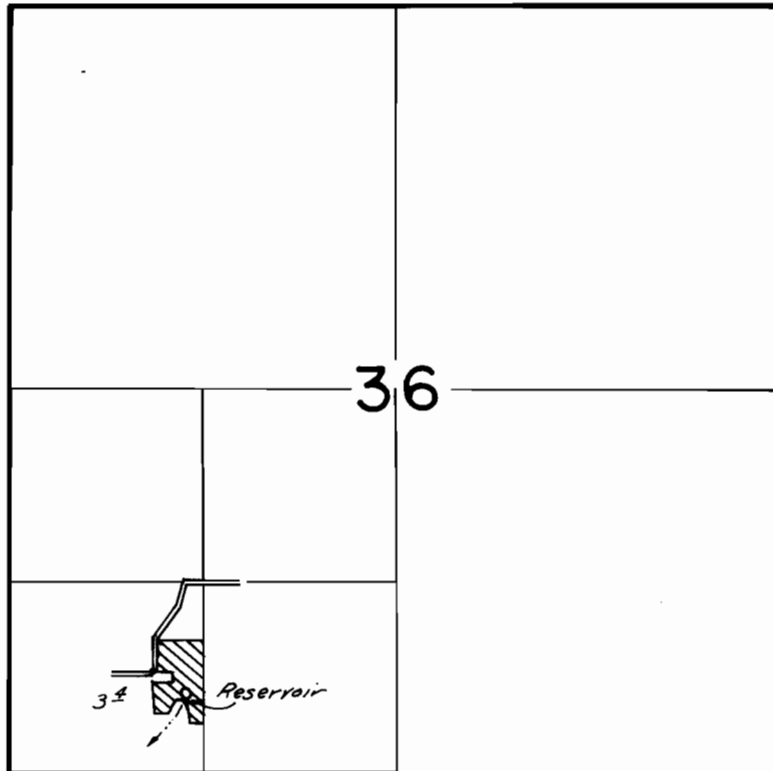

DIV. PT. LOC: 580' N. & 150' W. from SE cor. SW<sup>1</sup>/<sub>4</sub> SW<sup>1</sup>/<sub>4</sub>

**FINAL PROOF SURVEY**  
UNDER

Application No. R 53085 53086 Permit No. R 6201 38577

IN NAME OF

Elvira R. Peters

Surveyed June 19 1979, by J.C. Brown