


T.5S.,R.6W.,W.M.

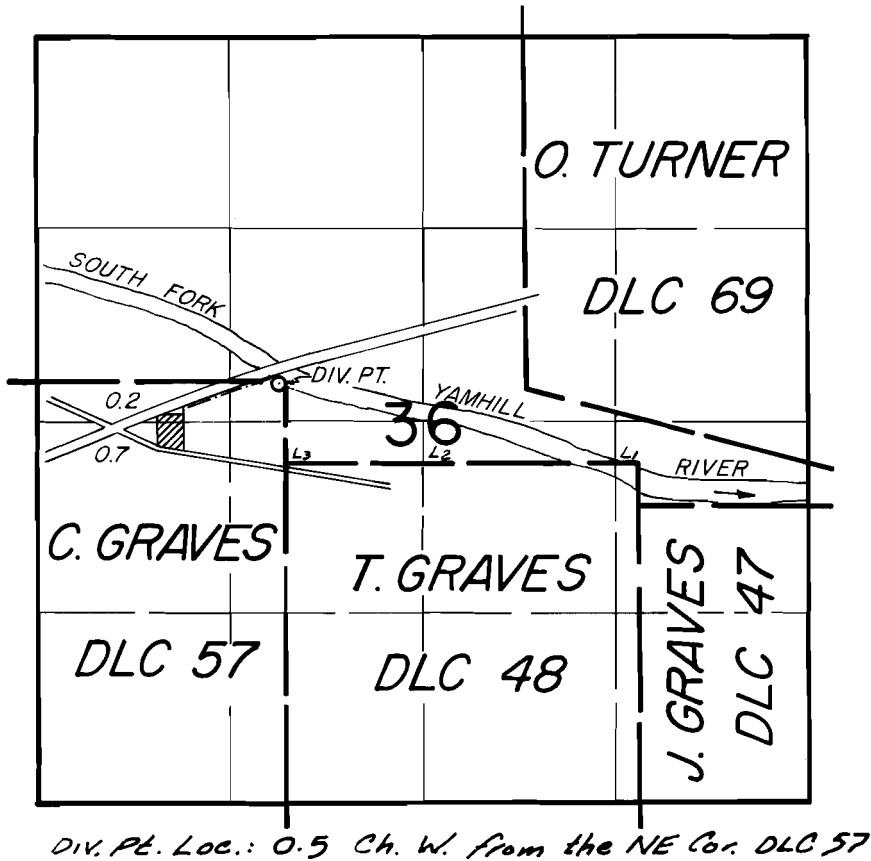

FINAL PROOF SURVEY UNDER

Application No. 53218. Permit No. 39492.....
IN NAME OF

ROMAN YODER

Surveyed JUNE 1, 1979, by *Al B. [Signature]*