T. 5S. R. 3W. W.M.

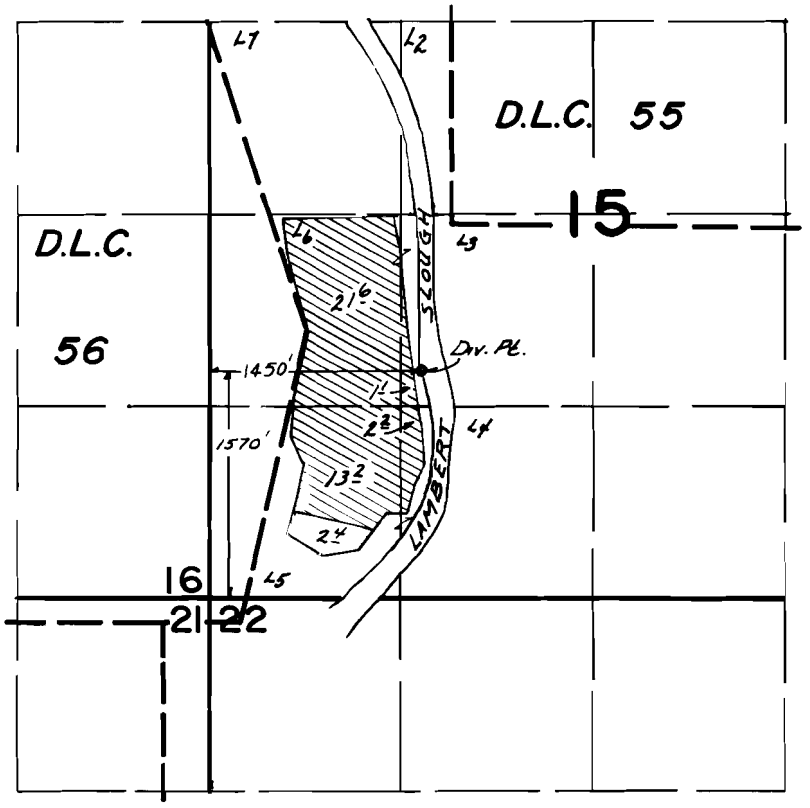

FINAL PROOF SURVEY
UNDER

Application No. 55396 53940 Permit No. 41806 40241
IN NAME OF

JAMES C. SHELBURNE

Surveyed March 6 1978, by L. H. Nunn

PTS-1978-P
DFG-211-219