


# T. 5S. R. 3W. W.M.

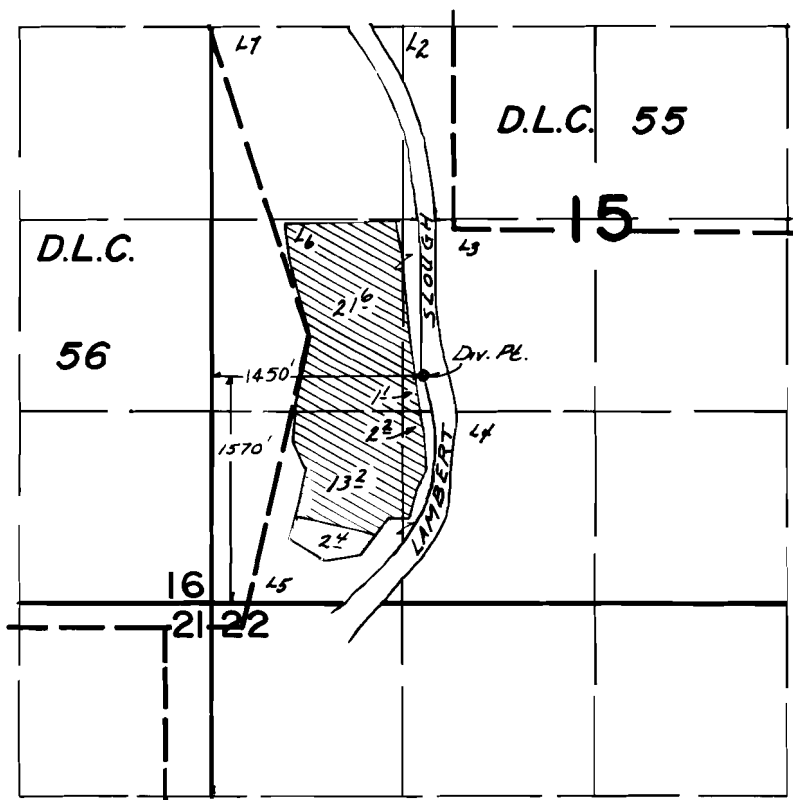

## FINAL PROOF SURVEY UNDER

Application No. **55396** Permit No. **41806**  
**53940** Permit No. **40241**  
IN NAME OF

**JAMES C. SHELBURNE**

Surveyed March 6 1978, by L.H. Nunn