


T-4671

# T. 28 S. R. 12 & 13 W. W. M.

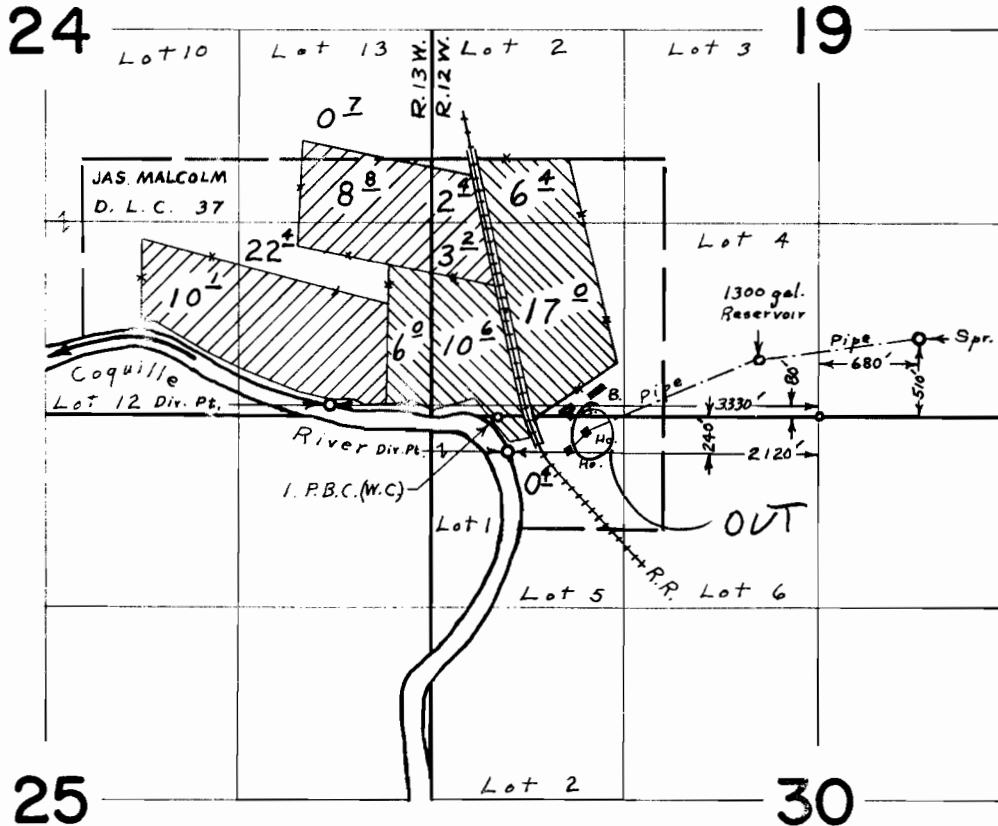

## FINAL PROOF SURVEY UNDER

Application No. 39192. Permit No. 29223.  
IN NAME OF

DONALD T. CROCKETT

Surveyed May 25 1967, by L. E. Gould