
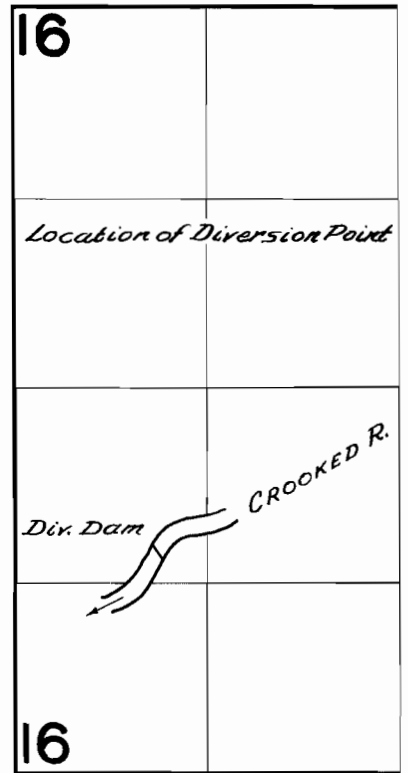


T.16S. R.18E.W.M.

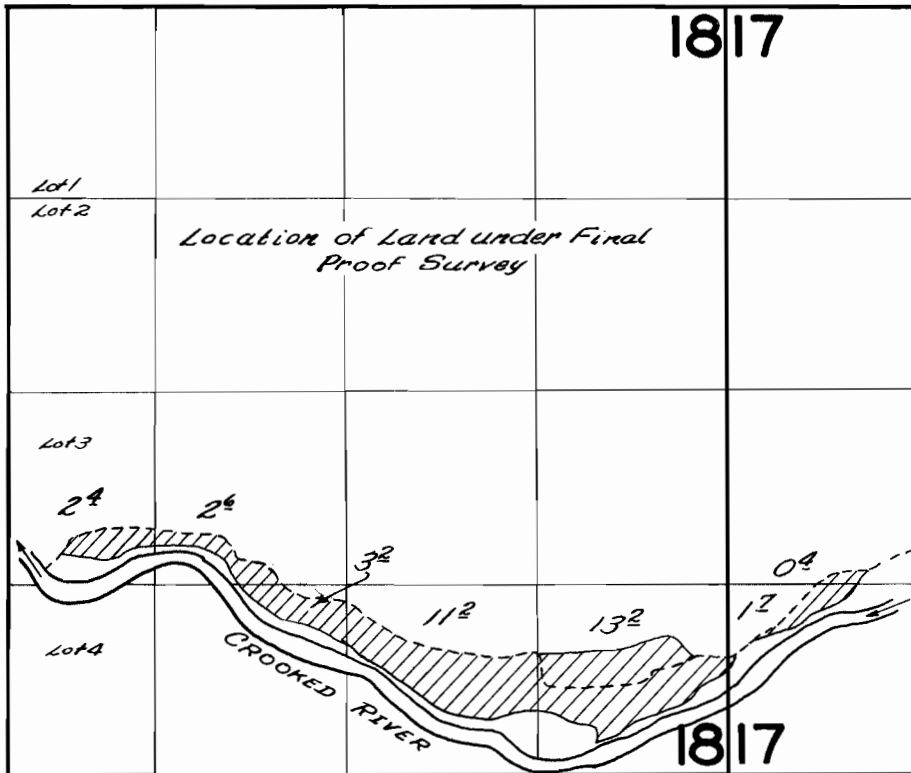

FINAL PROOF SURVEY  
UNDER



Application No. 18652... Permit No. 14284.  
IN NAME OF

... ESTATE OF MRS. BERTHA PORFELY ...

Surveyed May 11, 1955, by Trevor Jones.

T-4971

# T.16S. R.18E.W.M.

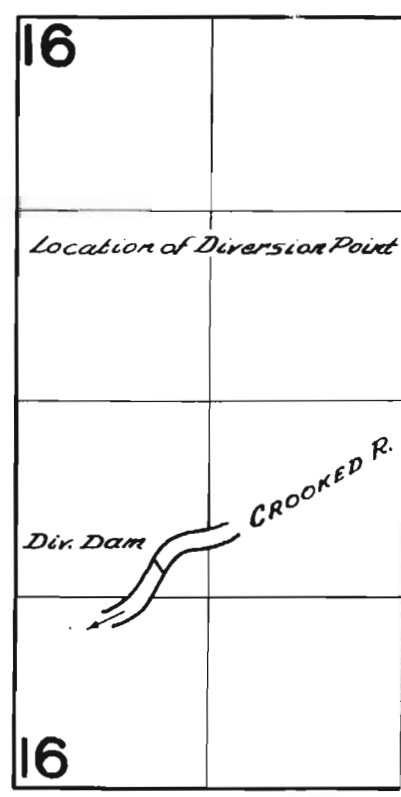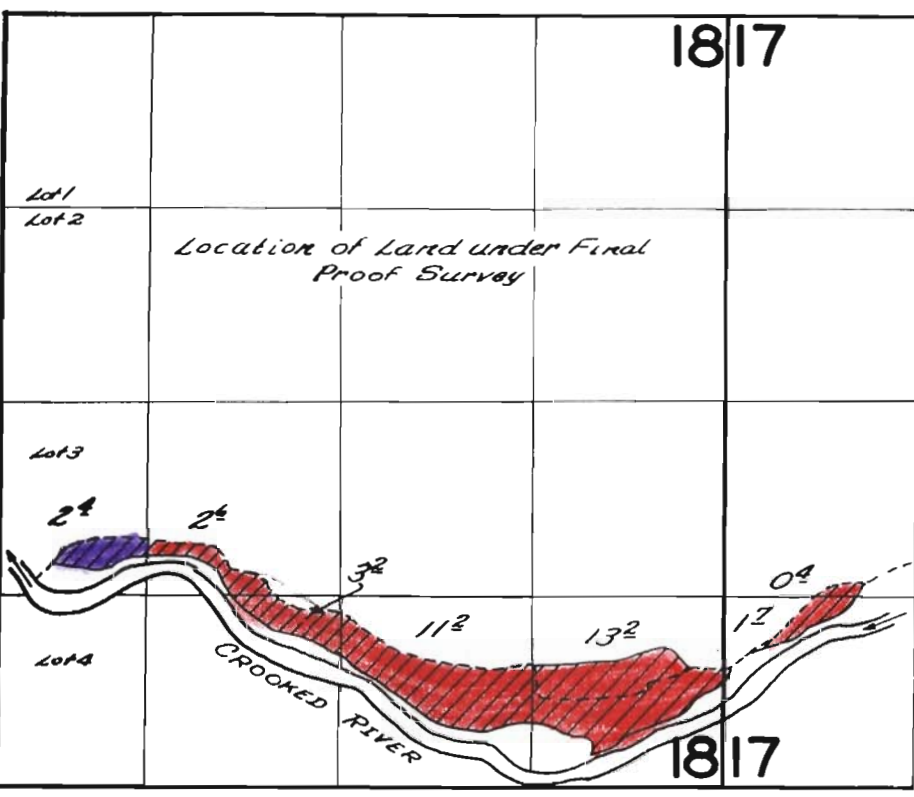

S - 18652  
 S - 14284  
 5094

T - 4971  
 S - 14284  
 64185

## FINAL PROOF SURVEY UNDER

Application No. 18652... Permit No. 14284  
IN NAME OF

ESTATE OF MRS. BERTHA PORFELY...

Surveyed May 11 1955, by Trevor Jones