


T. 25 S. R. 5 W. W. M.

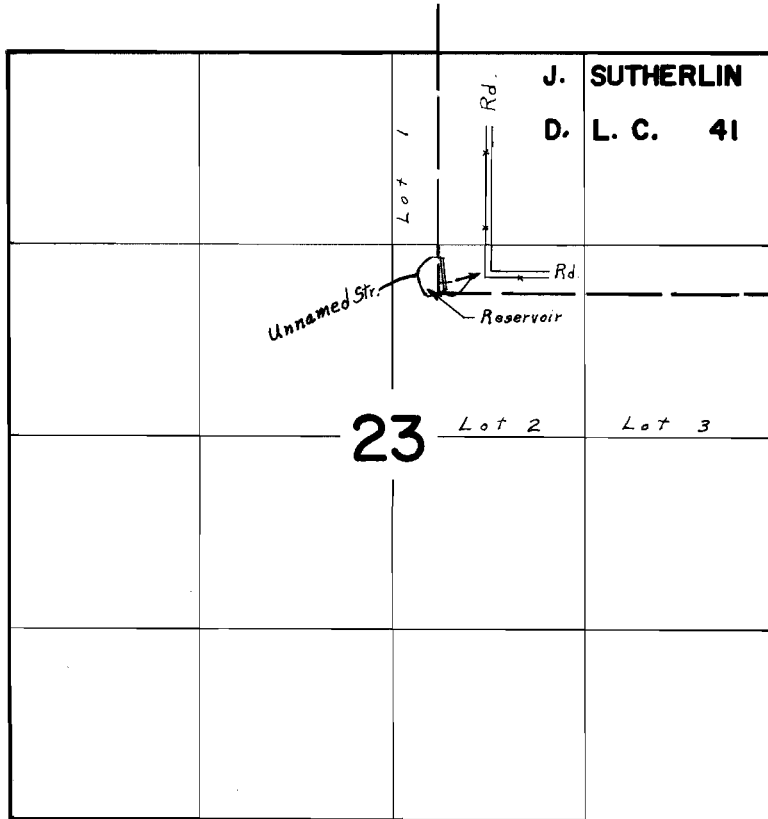

**FINAL PROOF SURVEY**  
UNDER

Application No. *R-41138*. Permit No. *R-4621*.  
IN NAME OF

**WAYNE S. RADER**

Surveyed *June 9, 1967*, by *L. E. Gould*