



Ben. B. Irving
 Ben. B. Irving
 Co. Surveyor

CLALLA CREEK

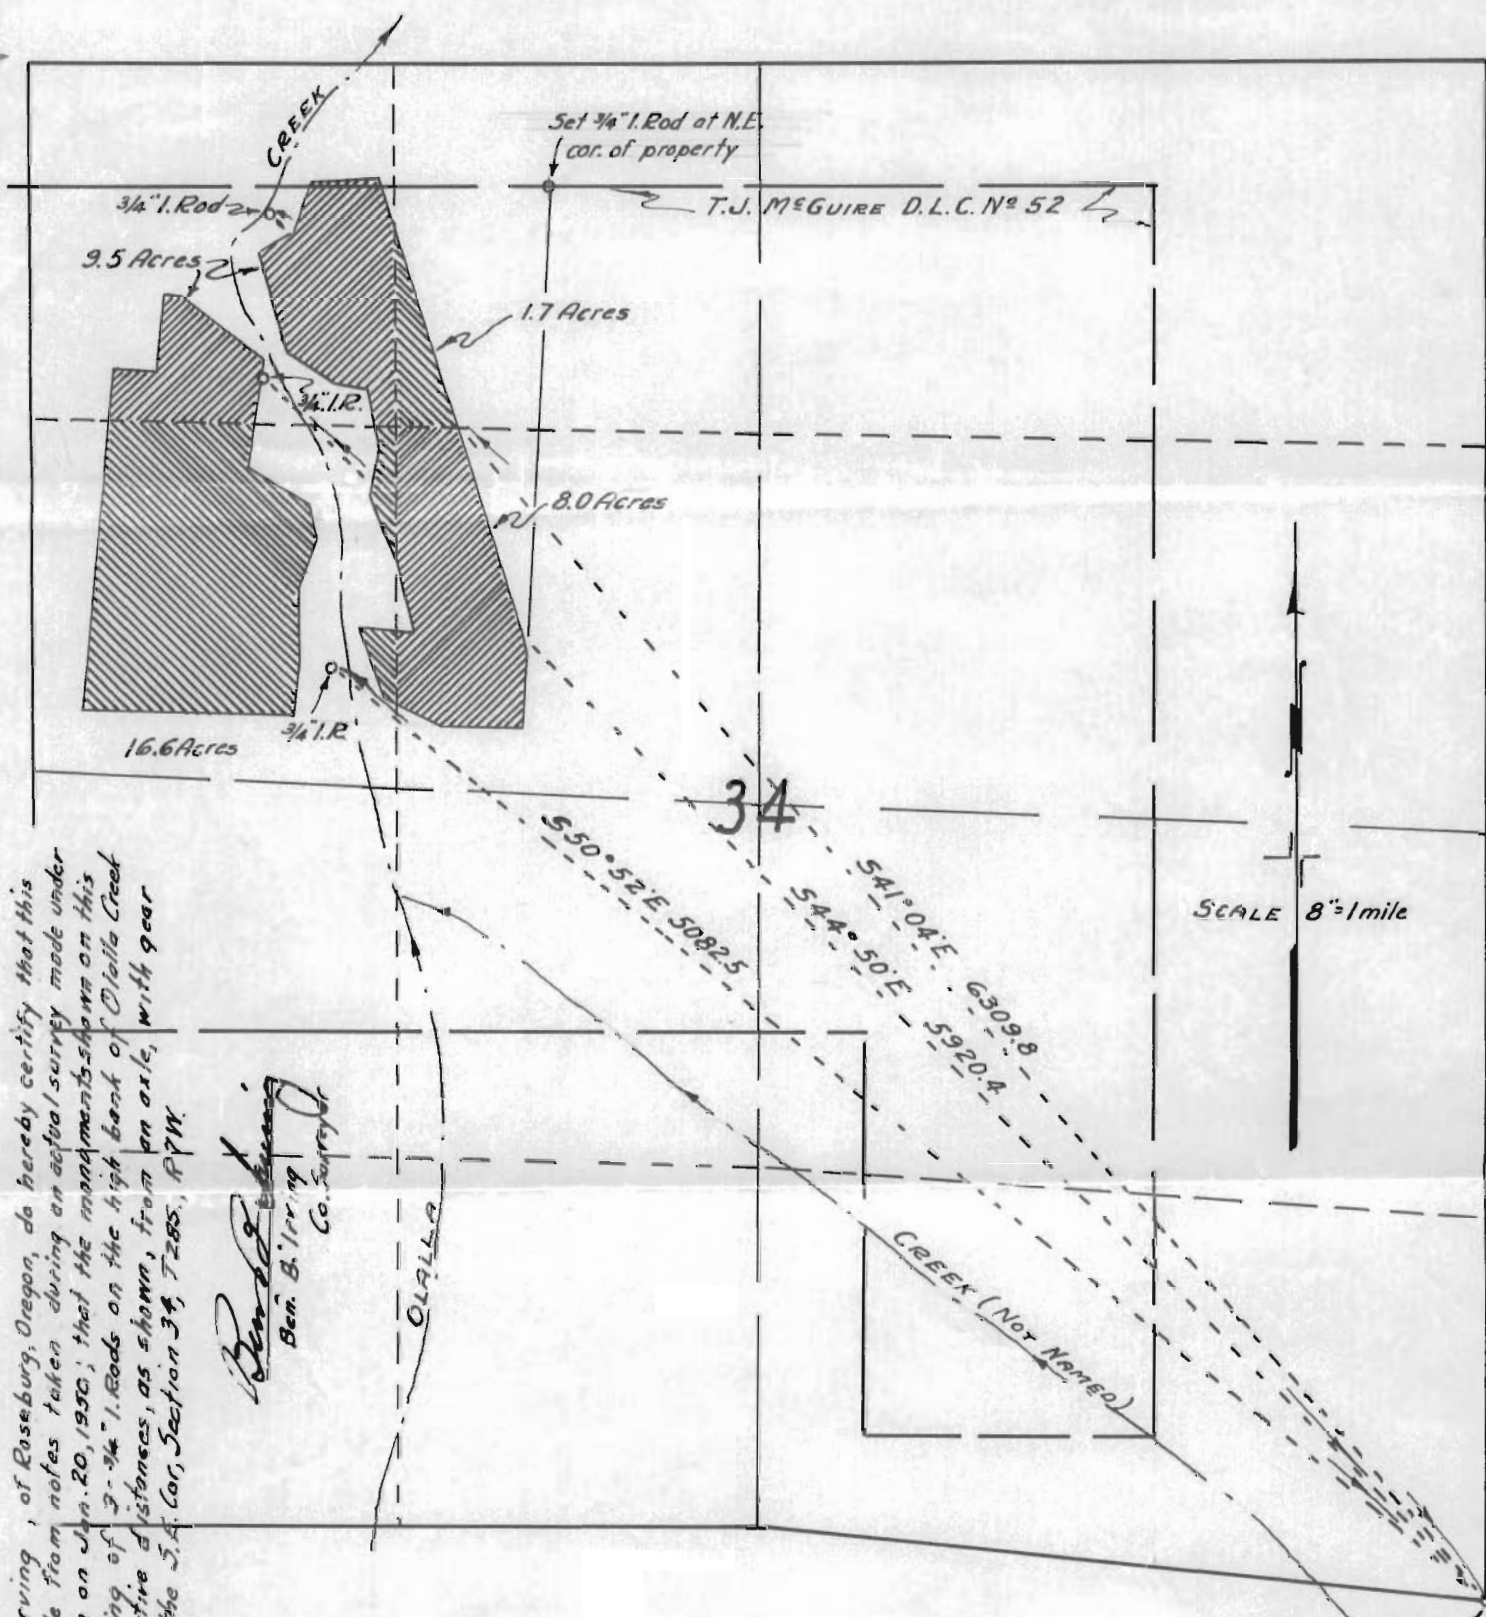

SCALE 8"=1 mile

Section Cor. $\frac{34.35}{312}$
 Fd. Axle, with gear attached.

**WATER RIGHT
 FOR
 DEAN ROSS
 SECTION 34. T28S. R7W. W.M.**

OFFICE OF
BEN. B. IRVING
 COUNTY SURVEYOR, DOUGLAS COUNTY,
 ROSEBURG, OREGON.



Application No. 24734
 Permit No. 19503