


T 24 S R 5 W W M

POD 520' S. & 740' W. from  
The E 1/4 Cor. of Sec. 34

**RECEIVED**

AUG 19 1974  
STATE ENGINEER  
SALEM, OREGON

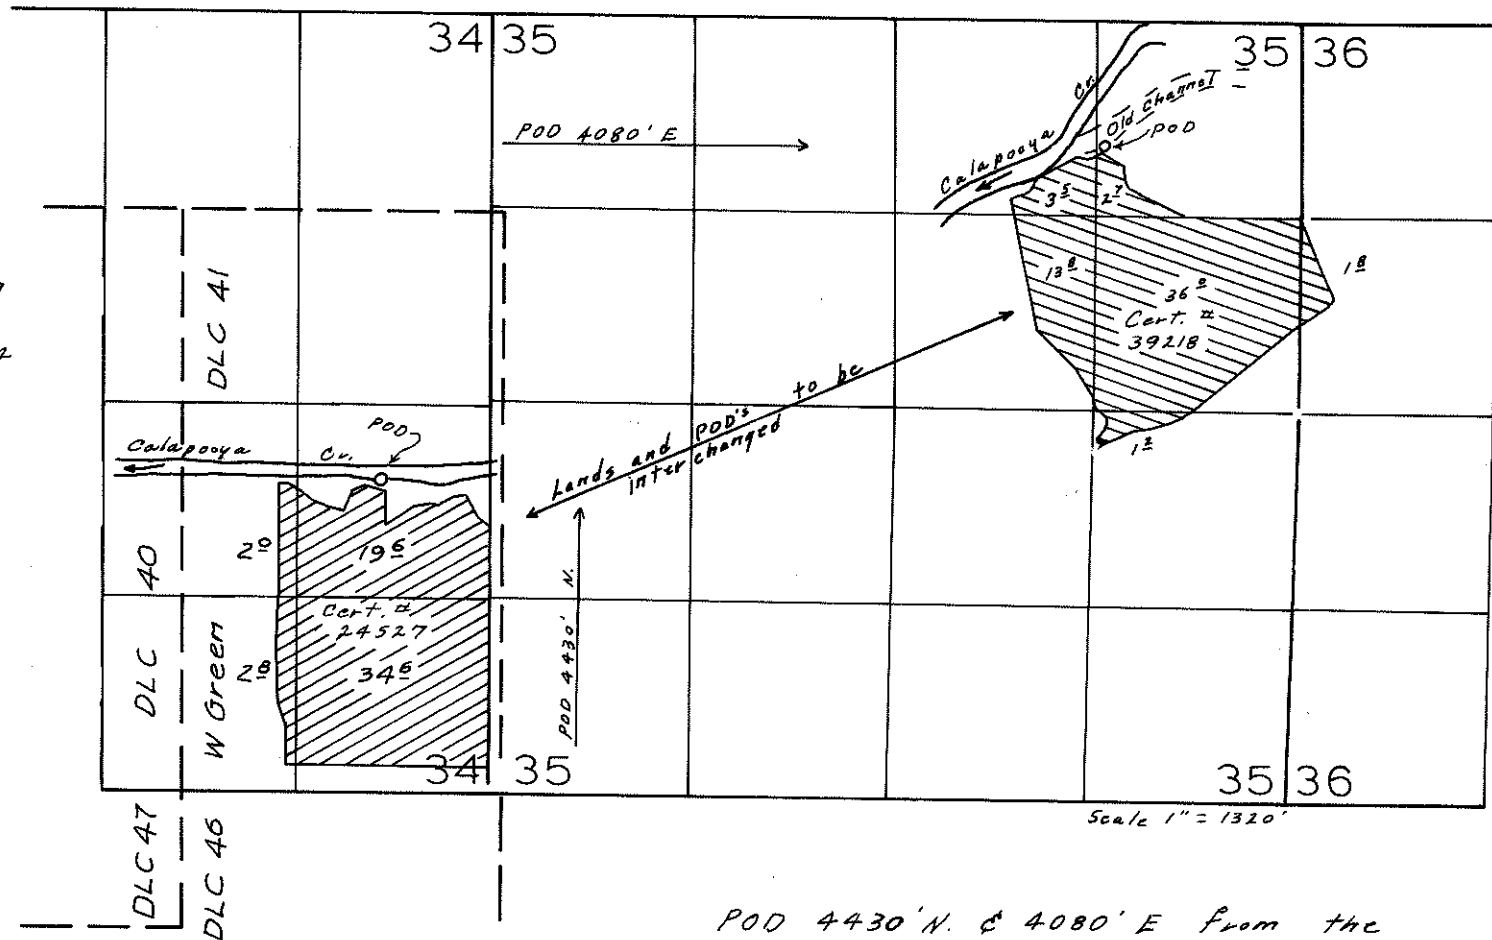

POD 4430' N. & 4080' E from the  
SW Cor. Sec. 35

T-3116