


T.27S. R.6W.W.M.

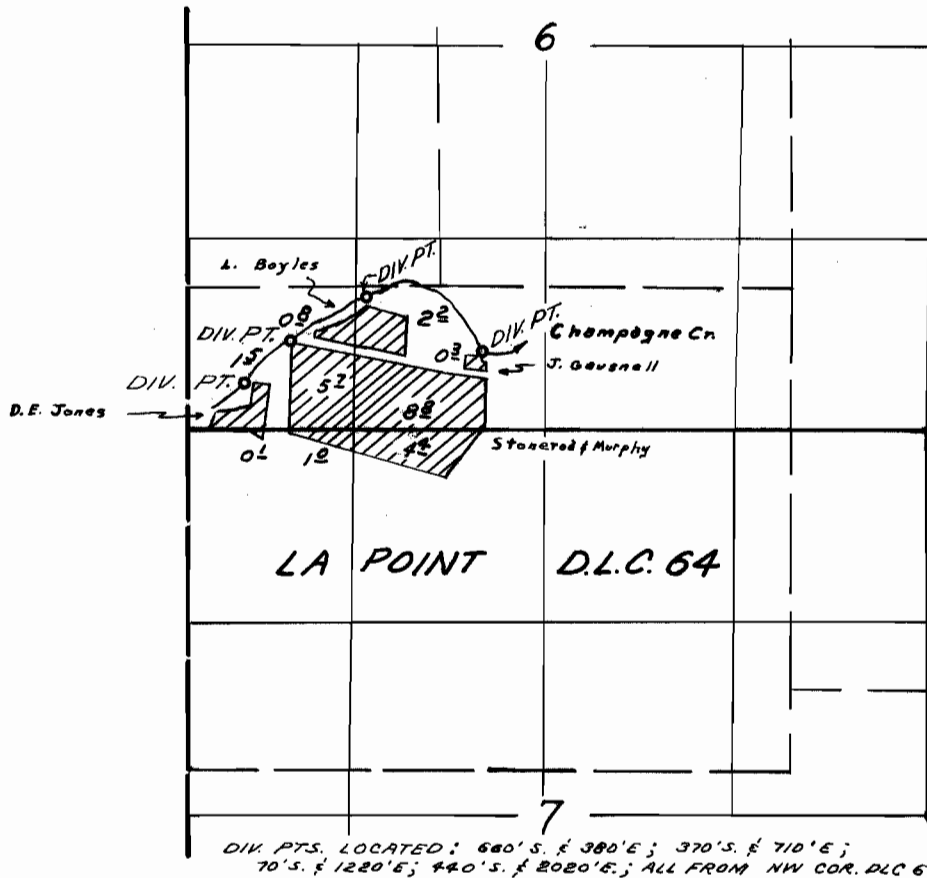

**FINAL PROOF SURVEY**  
UNDER

Application No. 39261 Permit No. 29244  
IN NAME OF  
**EARL STONEROD AND EDWARD M. MURPHY**  
**DENZIL E. AND OPAL J. JONES**

Surveyed Jan. 23 1968, by M. J. J.