


T.36S.R.6W.W.M

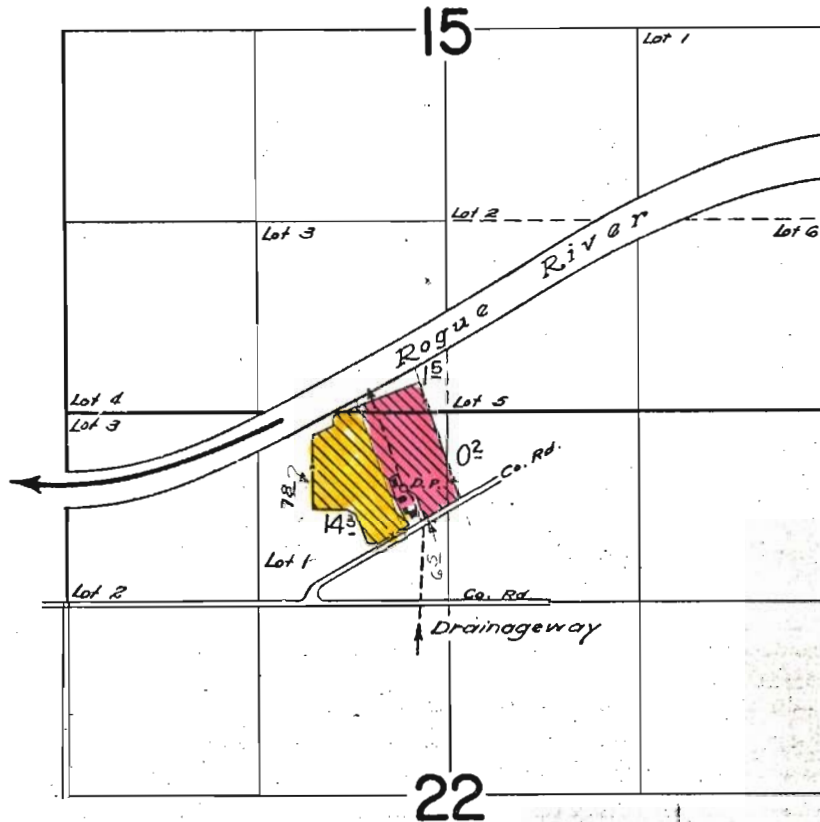

Canceled by PC 81-11



Remaining right (7^B Ac)

FINAL PROOF SURVEY UNDER

Application No. 38057... Permit No. 28381...
IN NAME OF

IRA W. MAY

Surveyed July 13, 1963, by *R. H. Jackson*