


T.36S. R.7W.W.M.

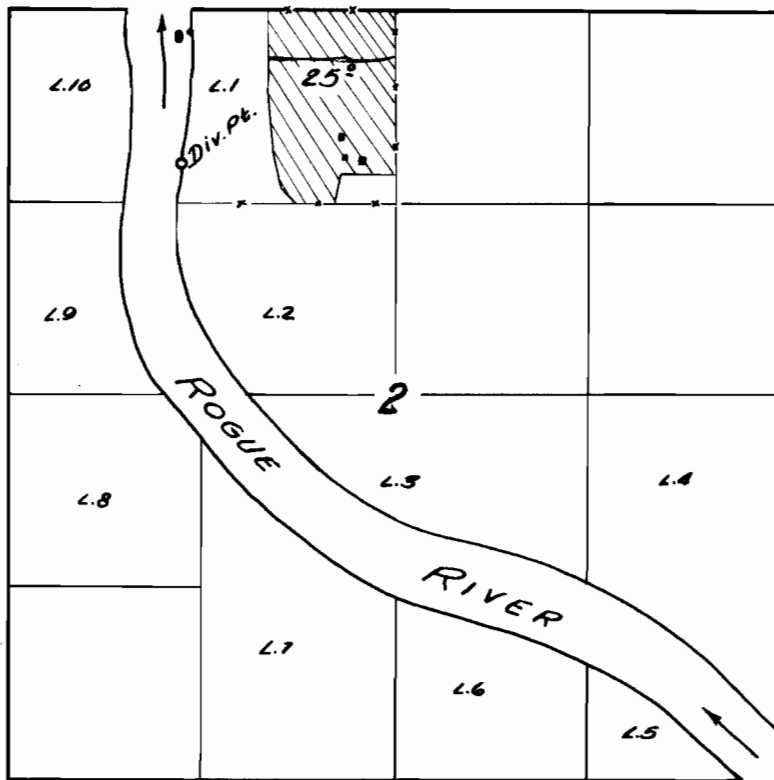

FINAL PROOF SURVEY

UNDER

Application No. ~~30803~~ Permit No. 24250

IN NAME OF

Ira A. Moore

Surveyed July 17, 1959, by Colminto