


T.3 N.R.27 E.W.M.

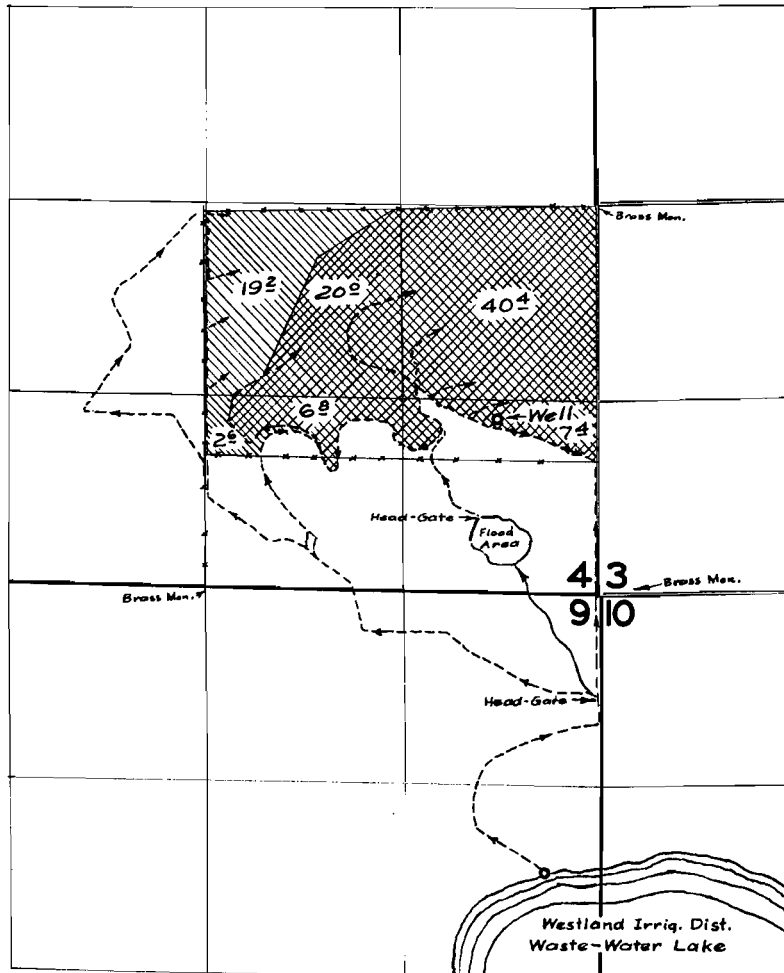

FINAL PROOF SURVEY
UNDER

Application No. G-94 30395 Permit No. G-48 24069
IN NAME OF

ERNEST J. ROYSTER

Surveyed 21 Nov. 1958, by M. Bish