


G-4469  
50925  
40926

# T. 1N., R. 32E., W.M.

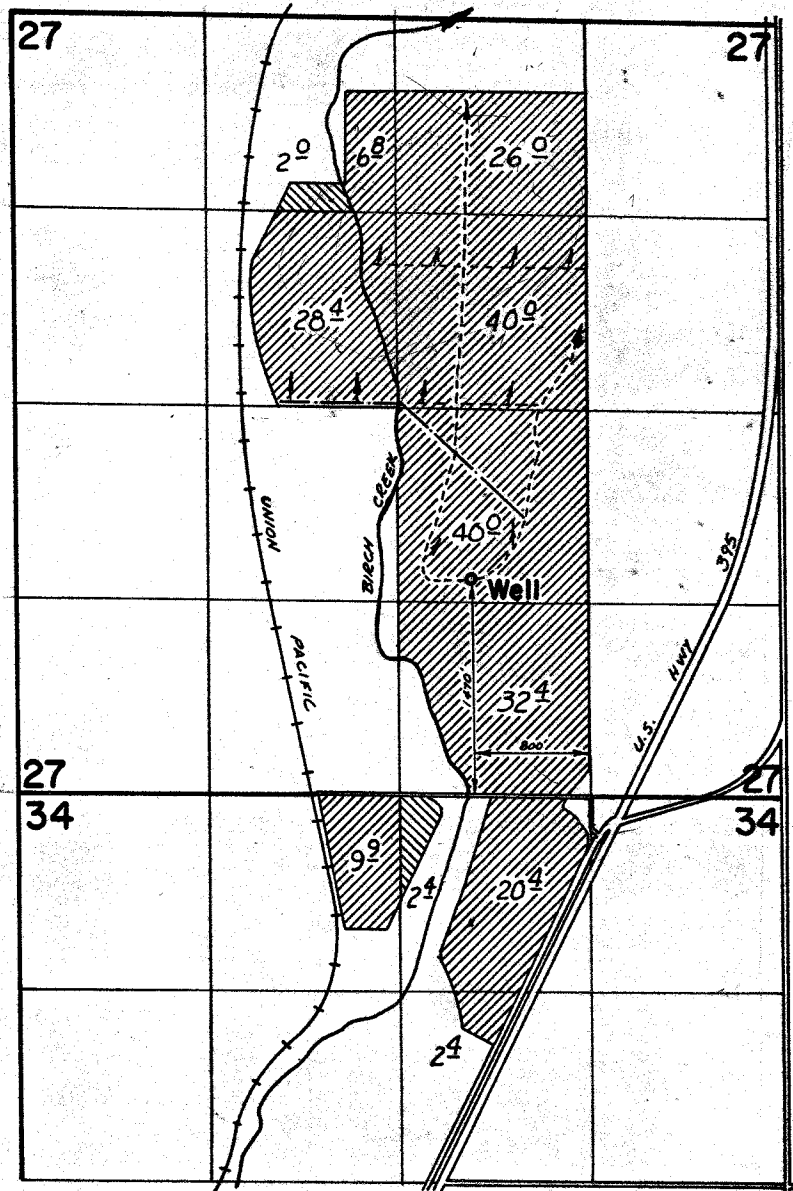

## FINAL PROOF SURVEY UNDER

 PRIMARY  
 SUPPLEMENTAL

Application No. G-4751 Permit No. G-4469  
IN NAME OF

CLARENCE C. HOEFT

Surveyed April 13, 1973, by D. Norby