


T.1&2S. R.12E. W.M.

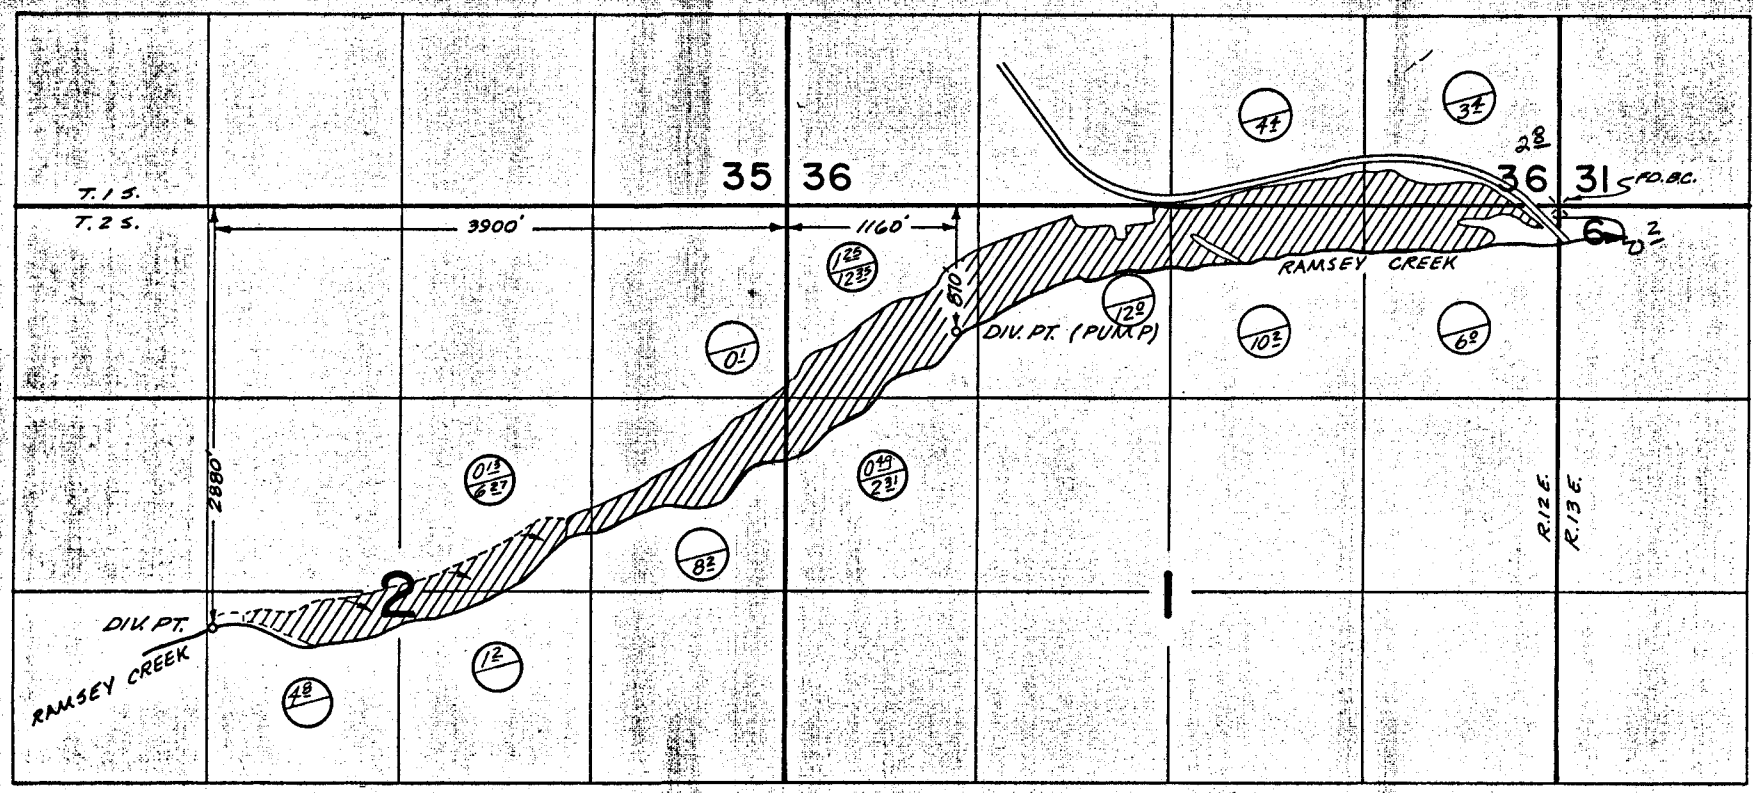

⊙ TRANSFER B145
 CERTIFICATE 5614

FINAL PROOF SURVEY

UNDER

Transfer No. B-145
 IN NAME OF

T. Leland Brown

Surveyed JULY 14, 1975 by T. S. PAUL

B-145