


T.3 S.R.3 W.W.M.

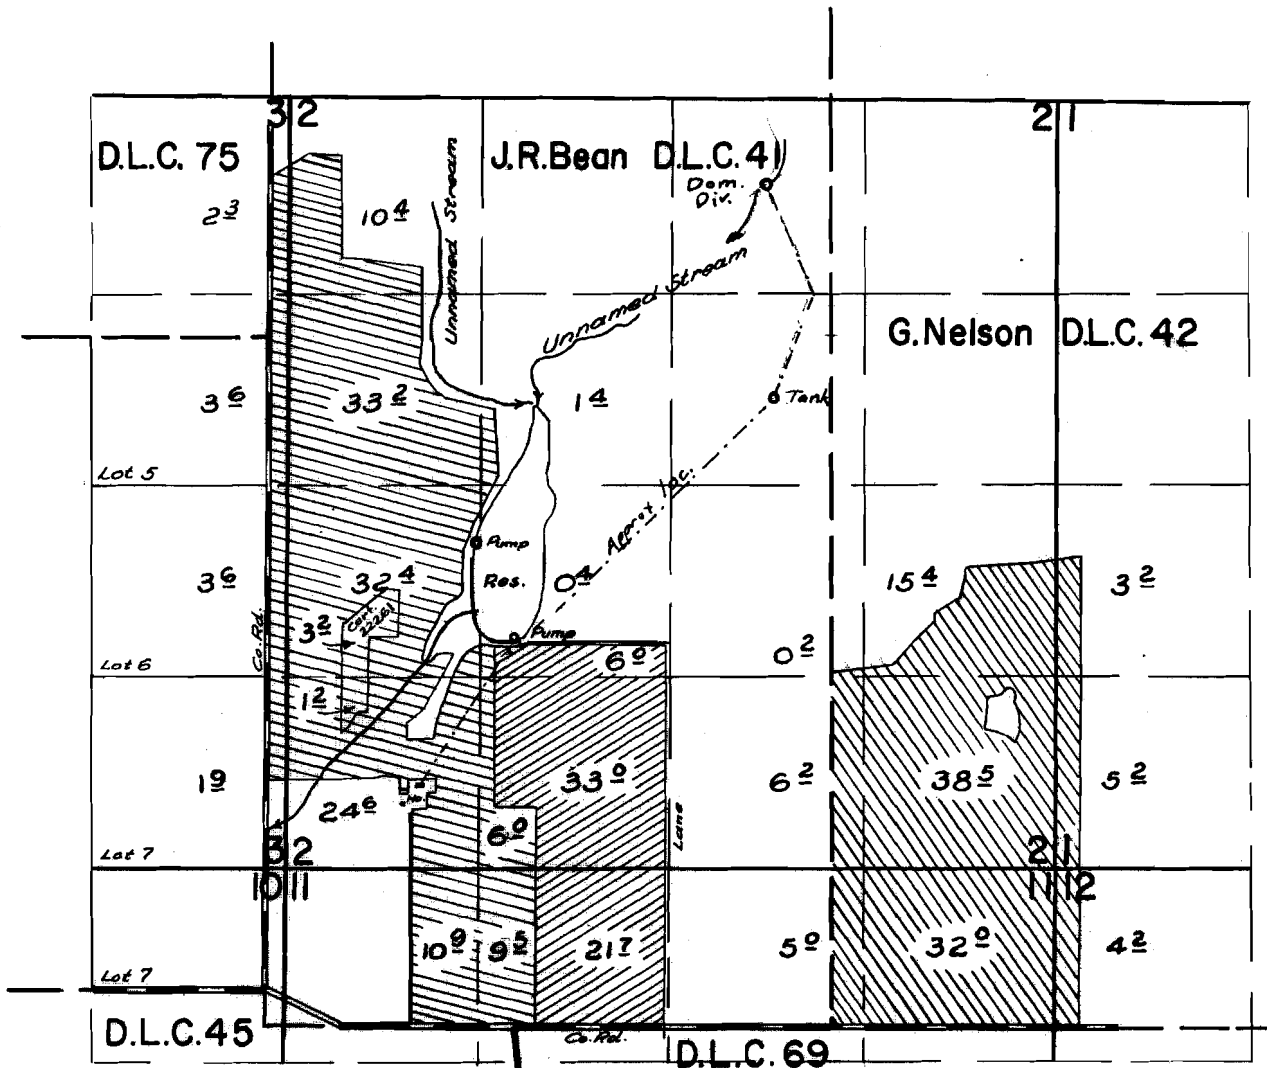

FINAL PROOF SURVEY

UNDER

R-25833
25834
R-28748
28749
R-29637
29638

R-1407
21656
R-1560
22616
R-1761
23676

Application No. 30831..... Permit No. 24269.....

IN NAME OF

R. L. WALKER

Surveyed 13 Mar. 1960, by M. B. Bish