


T. 8S. R. 40E. W.M.

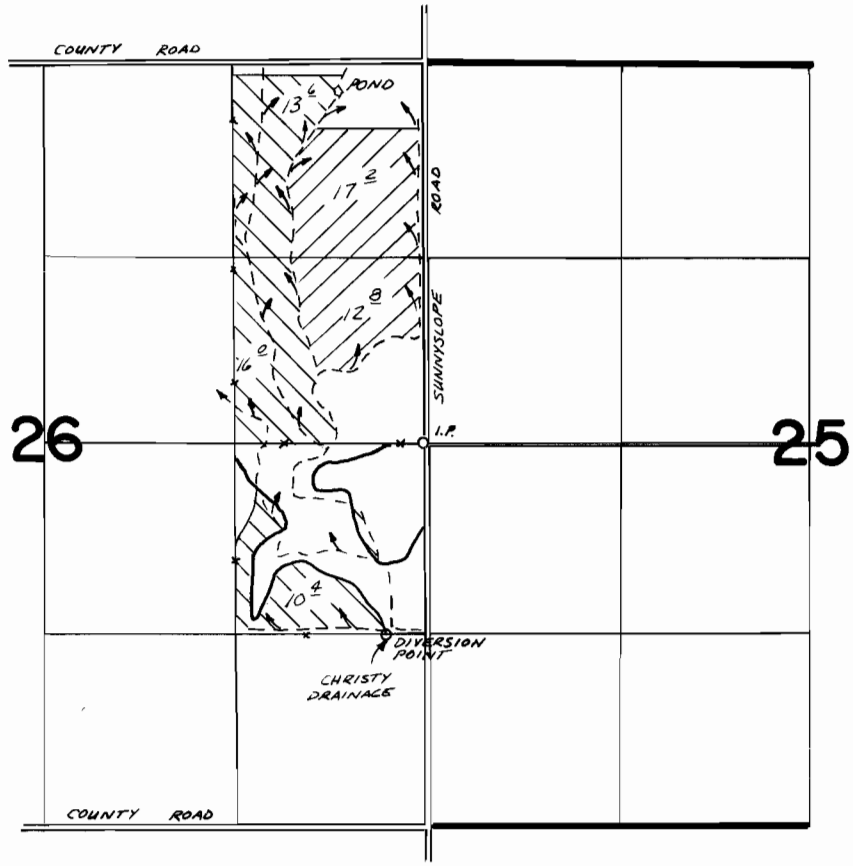

DIVERSION POINT LOCATED 1380' N. & 200' W. FROM SE COR SEC 26

FINAL PROOF SURVEY UNDER

50434 37473
 Application No. 53884 Permit No. 40205
 IN NAME OF



DONALD WILLIAM CHRISTY

Surveyed OCT. 28 19 77, by R. BARWIN
MAY 22 78