


T. 8S. R. 40E. W.M.

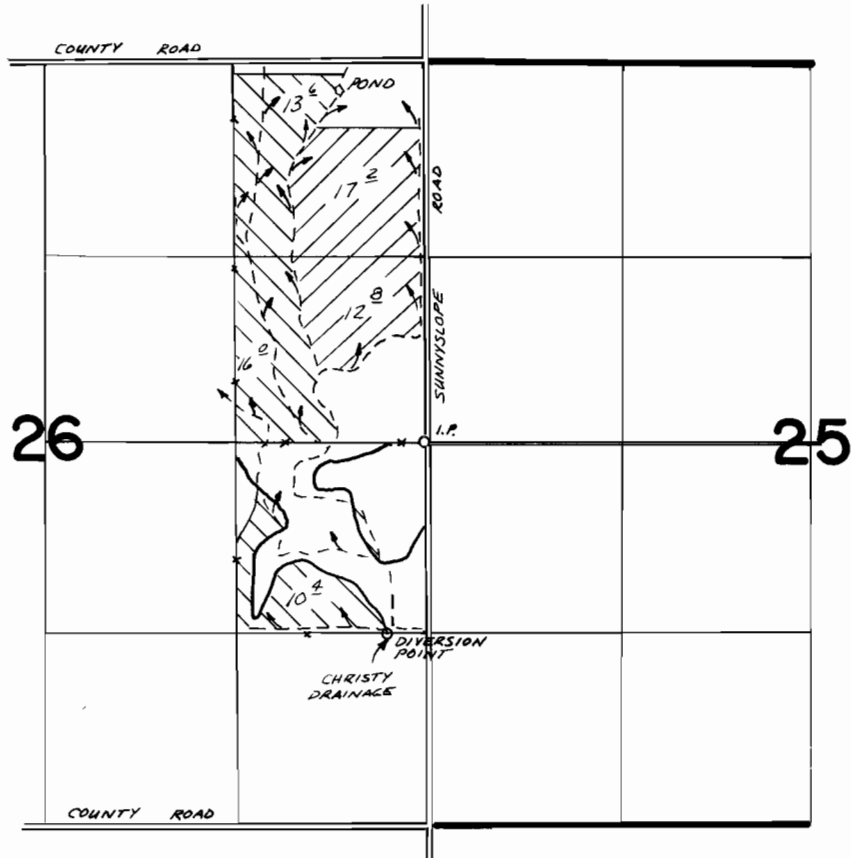

DIVERSION POINT LOCATED 1380' N. & 200' W. FROM SE COR SEC 26

**FINAL PROOF SURVEY**  
UNDER

50434                      37473  
Application No. 53884    Permit No. 40205  
IN NAME OF



**DONALD WILLIAM CHRISTY**

Surveyed OCT. 28 19 77, by R. BARWIN  
MAY 22 78