


T. 7S. R. 39E. W.M.

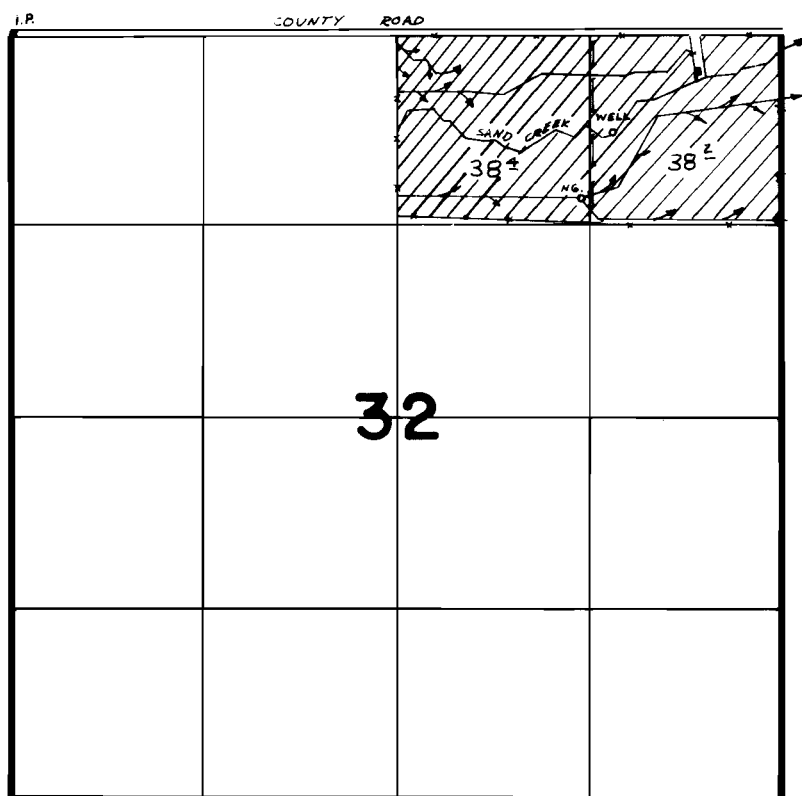

WELL LOC. 700'S. & 1150' W FROM NE COR SEC 32

FINAL PROOF SURVEY
UNDER

Application No. **G-5509** Permit No. **G-5403**
IN NAME OF

DORIS M. PREOBSTEL

Surveyed **6-6** 1978, by **R. DARWIN**