


T. 7S. R. 45E. W.M.

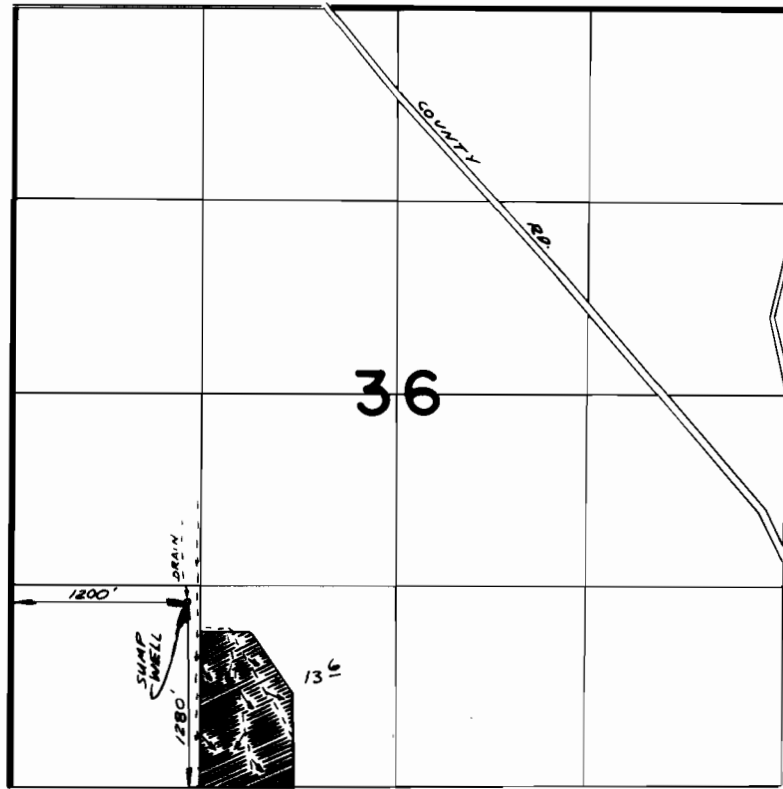

FINAL PROOF SURVEY
UNDER

Application No. G-6049 Permit No. G-5735
IN NAME OF

MERLE HOGG

Surveyed 5-31 1978, by R. BARWIN