


T. 8S. R. 39E. W. M.

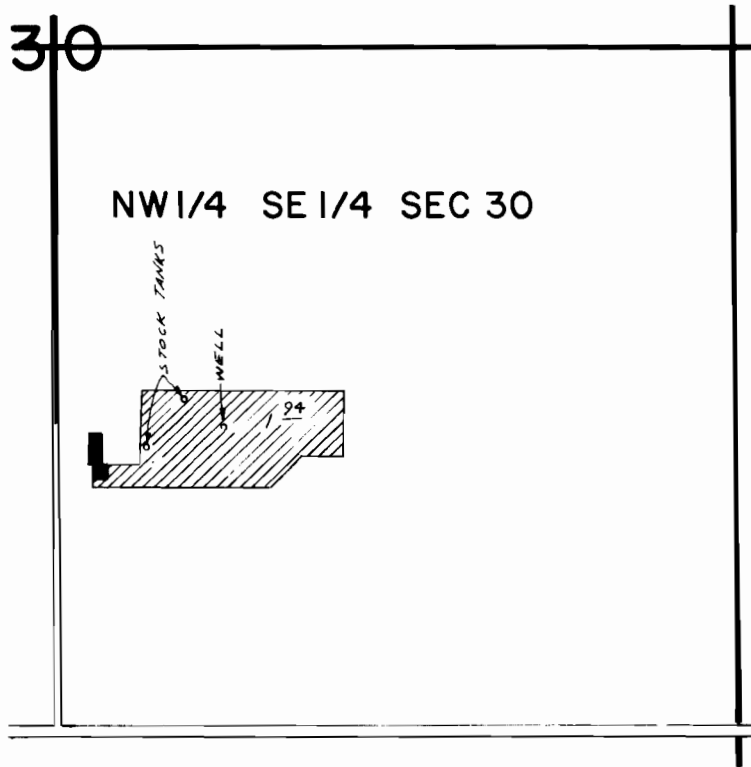

WELL LOC. 700'S & 350'E FROM CENTER SEC 30

SCALE 1" = 400'

**FINAL PROOF SURVEY**  
UNDER

Application No. G-8362 Permit No. G-7754  
IN NAME OF

**JAMES F. CRAIG**

Surveyed 6-6-1978, by R. BARWIN