


T3S. RIW. WM.

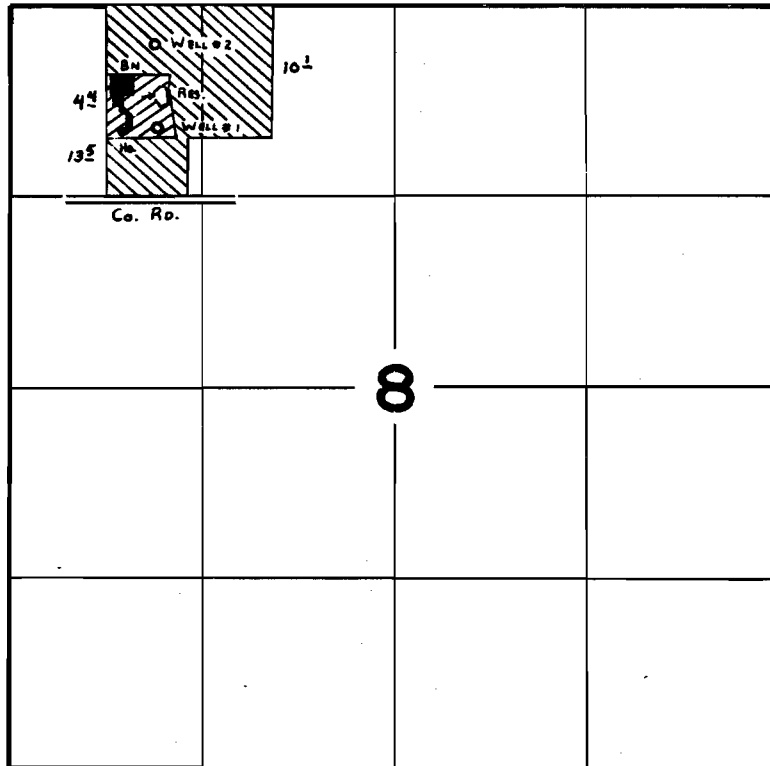

WELLS LOC: #1- 850'S. & 1010'E. }
 #2- 280'S. & 990'E. } ALL FROM N.W. COR. SEC. 8.
 RES. LOC: 620'S. & 1070'E.
 [Diagonal lines symbol] - IRR. FR. WELL #1
 [Cross-hatched symbol] - PRIMARY IRR. FROM RES; SUPPLEMENTAL IRR. FROM WELL #2.

FINAL PROOF SURVEY UNDER

G-8389 G-7562
 56456 41969
 Application No. R-56455 Permit No. R-6641...
 IN NAME OF
BEN & LYNDEN LANGSTON
 Surveyed JUNE 5, 1978, by C. L. HUGHES...