



15  
13E

5677

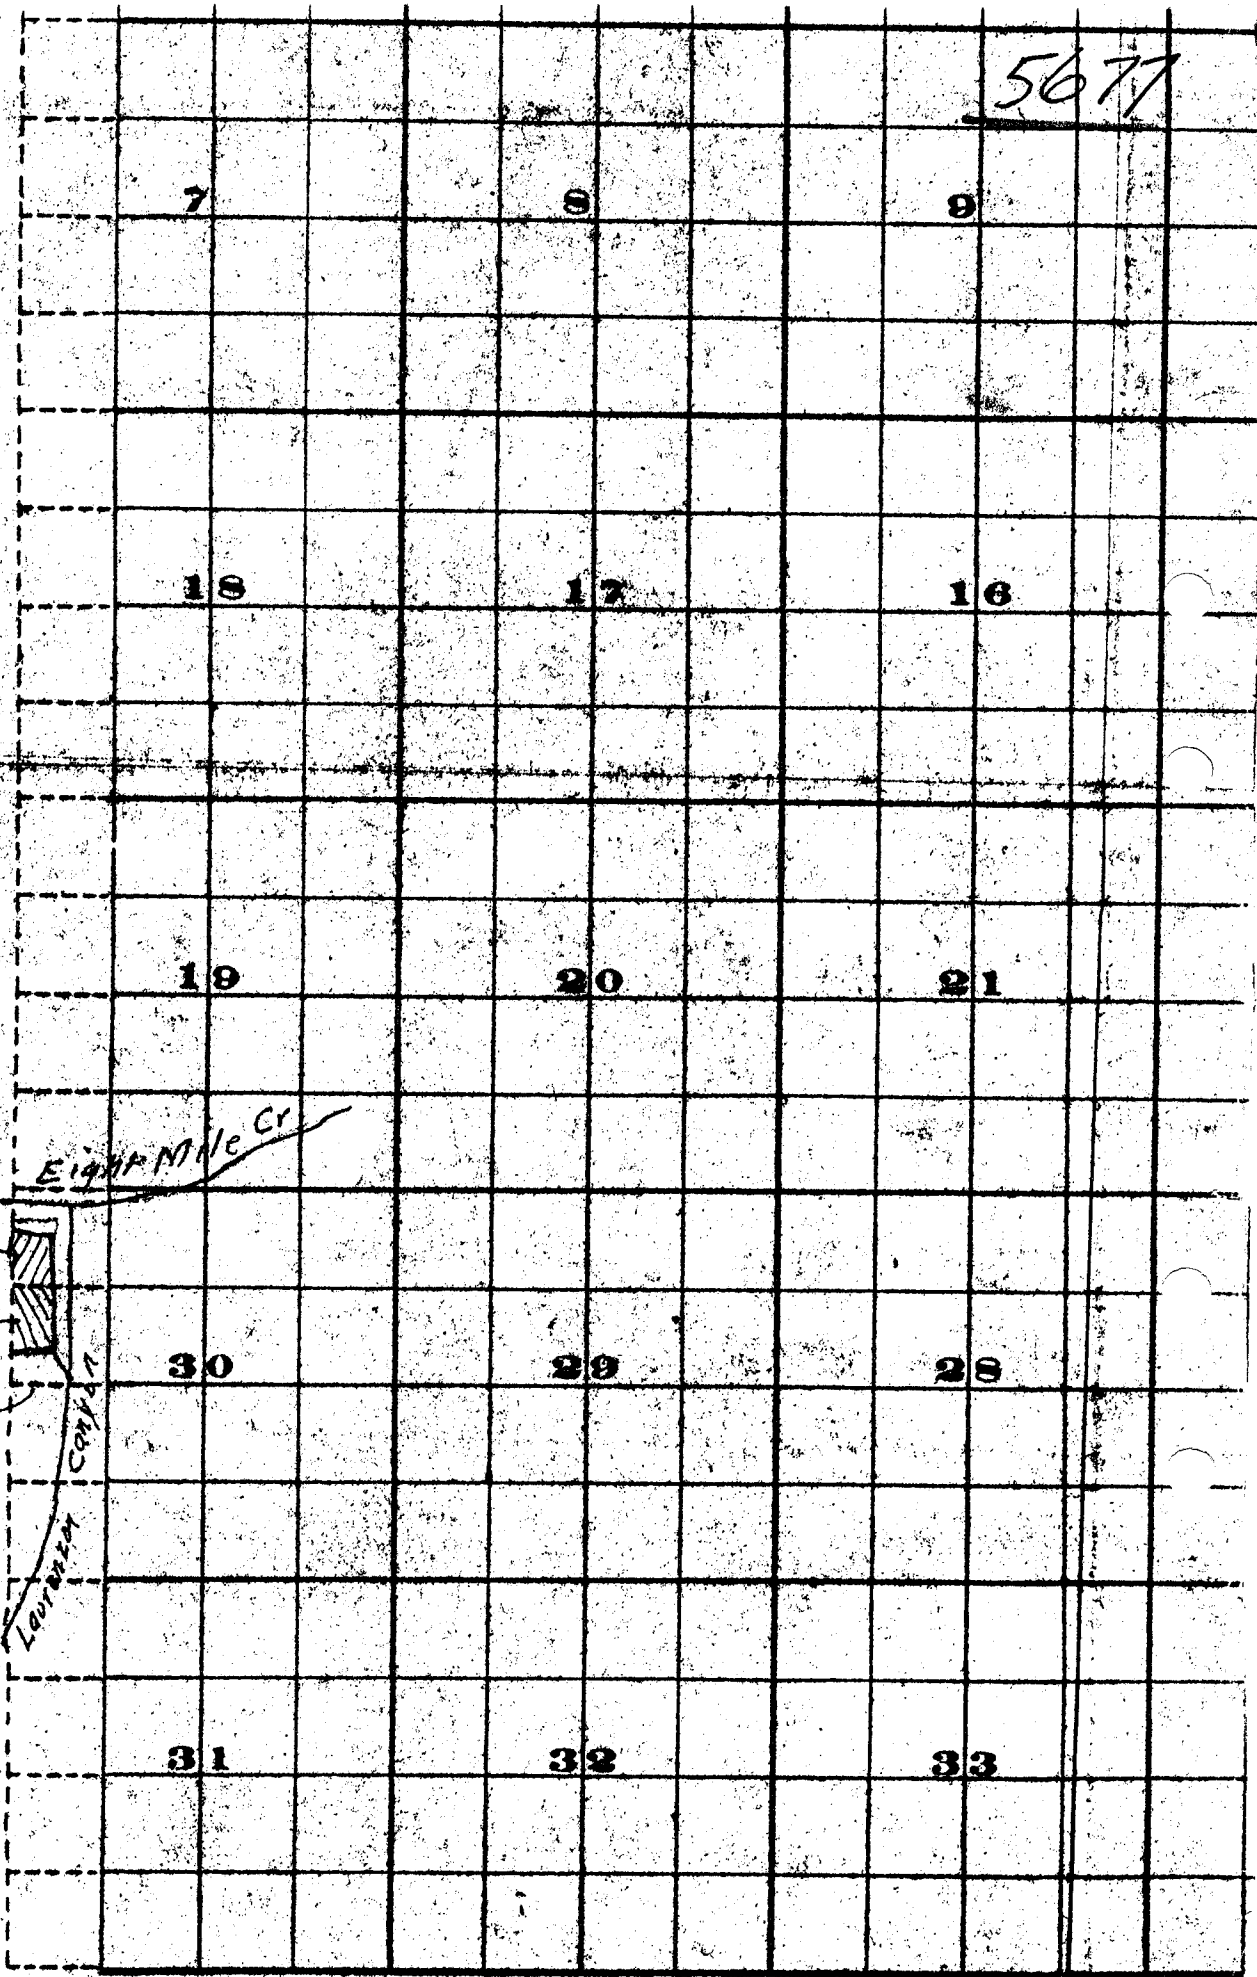

2228

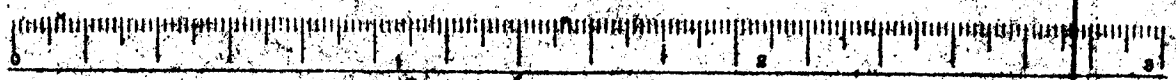

Scale of Feet.