


T3S. RIW. WM.

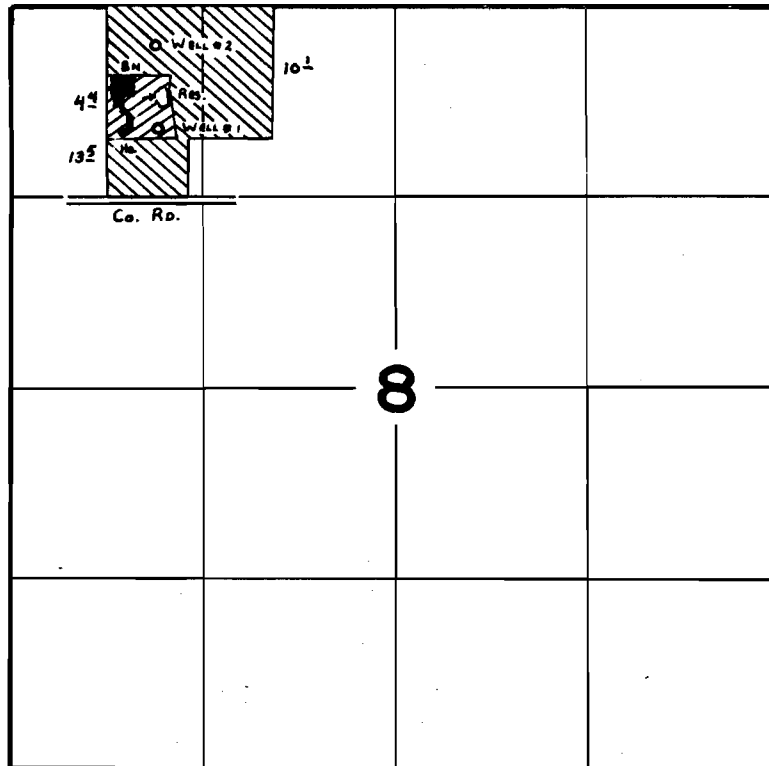

WELLS LOC: #1-850'S. & 1010'E. }
 #2-280'S. & 990'E. } All From N.W. Cor. Sec. 8.
 RES. LOC: 620'S. & 1070'E.
 [Diagonal Lines] - IRR. FR. WELL #1
 [Cross-hatch] - PRIMARY IRR. FROM RES; SUPPLEMENTAL IRR. FROM WELL #2.

FINAL PROOF SURVEY UNDER

G-8389 G-7562
 56456 41969
 Application No. R-56455 Permit No. R-6641
 IN NAME OF
BEN & LYNDEN LANGSTON
 Surveyed JUNE 5 1978, by C. L. HUGHES