


# T.3S.R.2E.W.M.

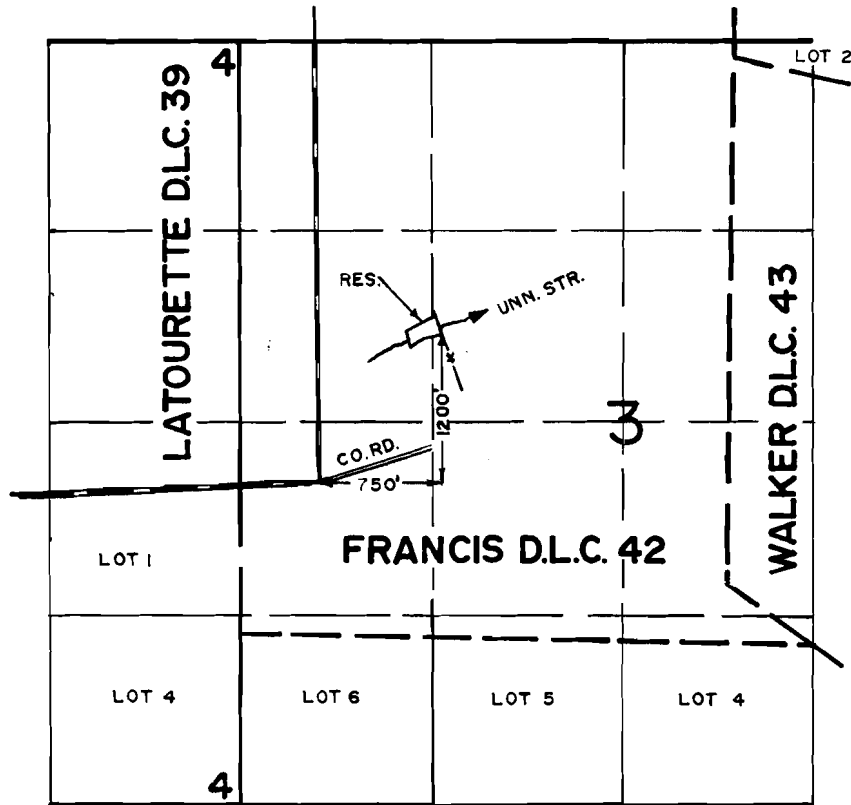

## FINAL PROOF SURVEY

UNDER

R-54291                      R-6479  
Application No. 54292 Permit No. 40593  
IN NAME OF

Manuel E. Martinez

Surveyed MAR. 6..... 1980, by R.G. MUCKEN.....