


T.3S.R.2E.W.M.

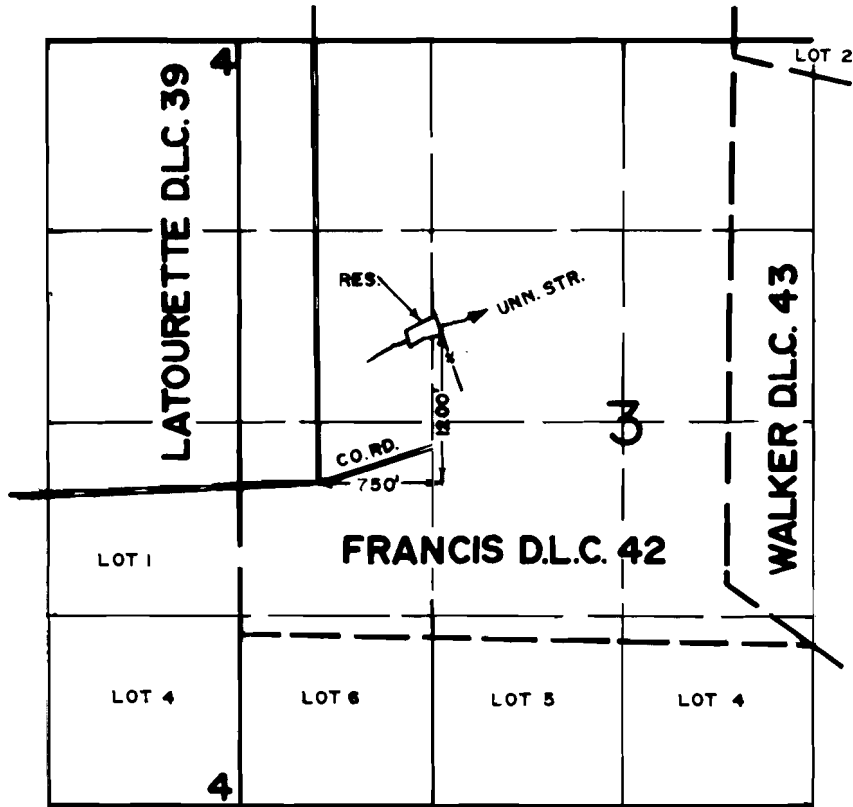

FINAL PROOF SURVEY

UNDER

R-54291 R-6479
Application No. **54292** Permit No. **40593**.....
IN NAME OF

Manuel E. Martinez

Surveyed **MAR. 6**.... 19**80**, by **R.G. MICKEN**.....